


BOUNDARY & TOPOGRAPHIC SURVEY

LOTS 2 & 3 EAST TROY INDUSTRIAL PARK
SEC. 29, TOWN 4 NORTH, RANGE 18 EAST
VILLAGE OF EAST TROY
WALWORTH COUNTY, WISCONSIN

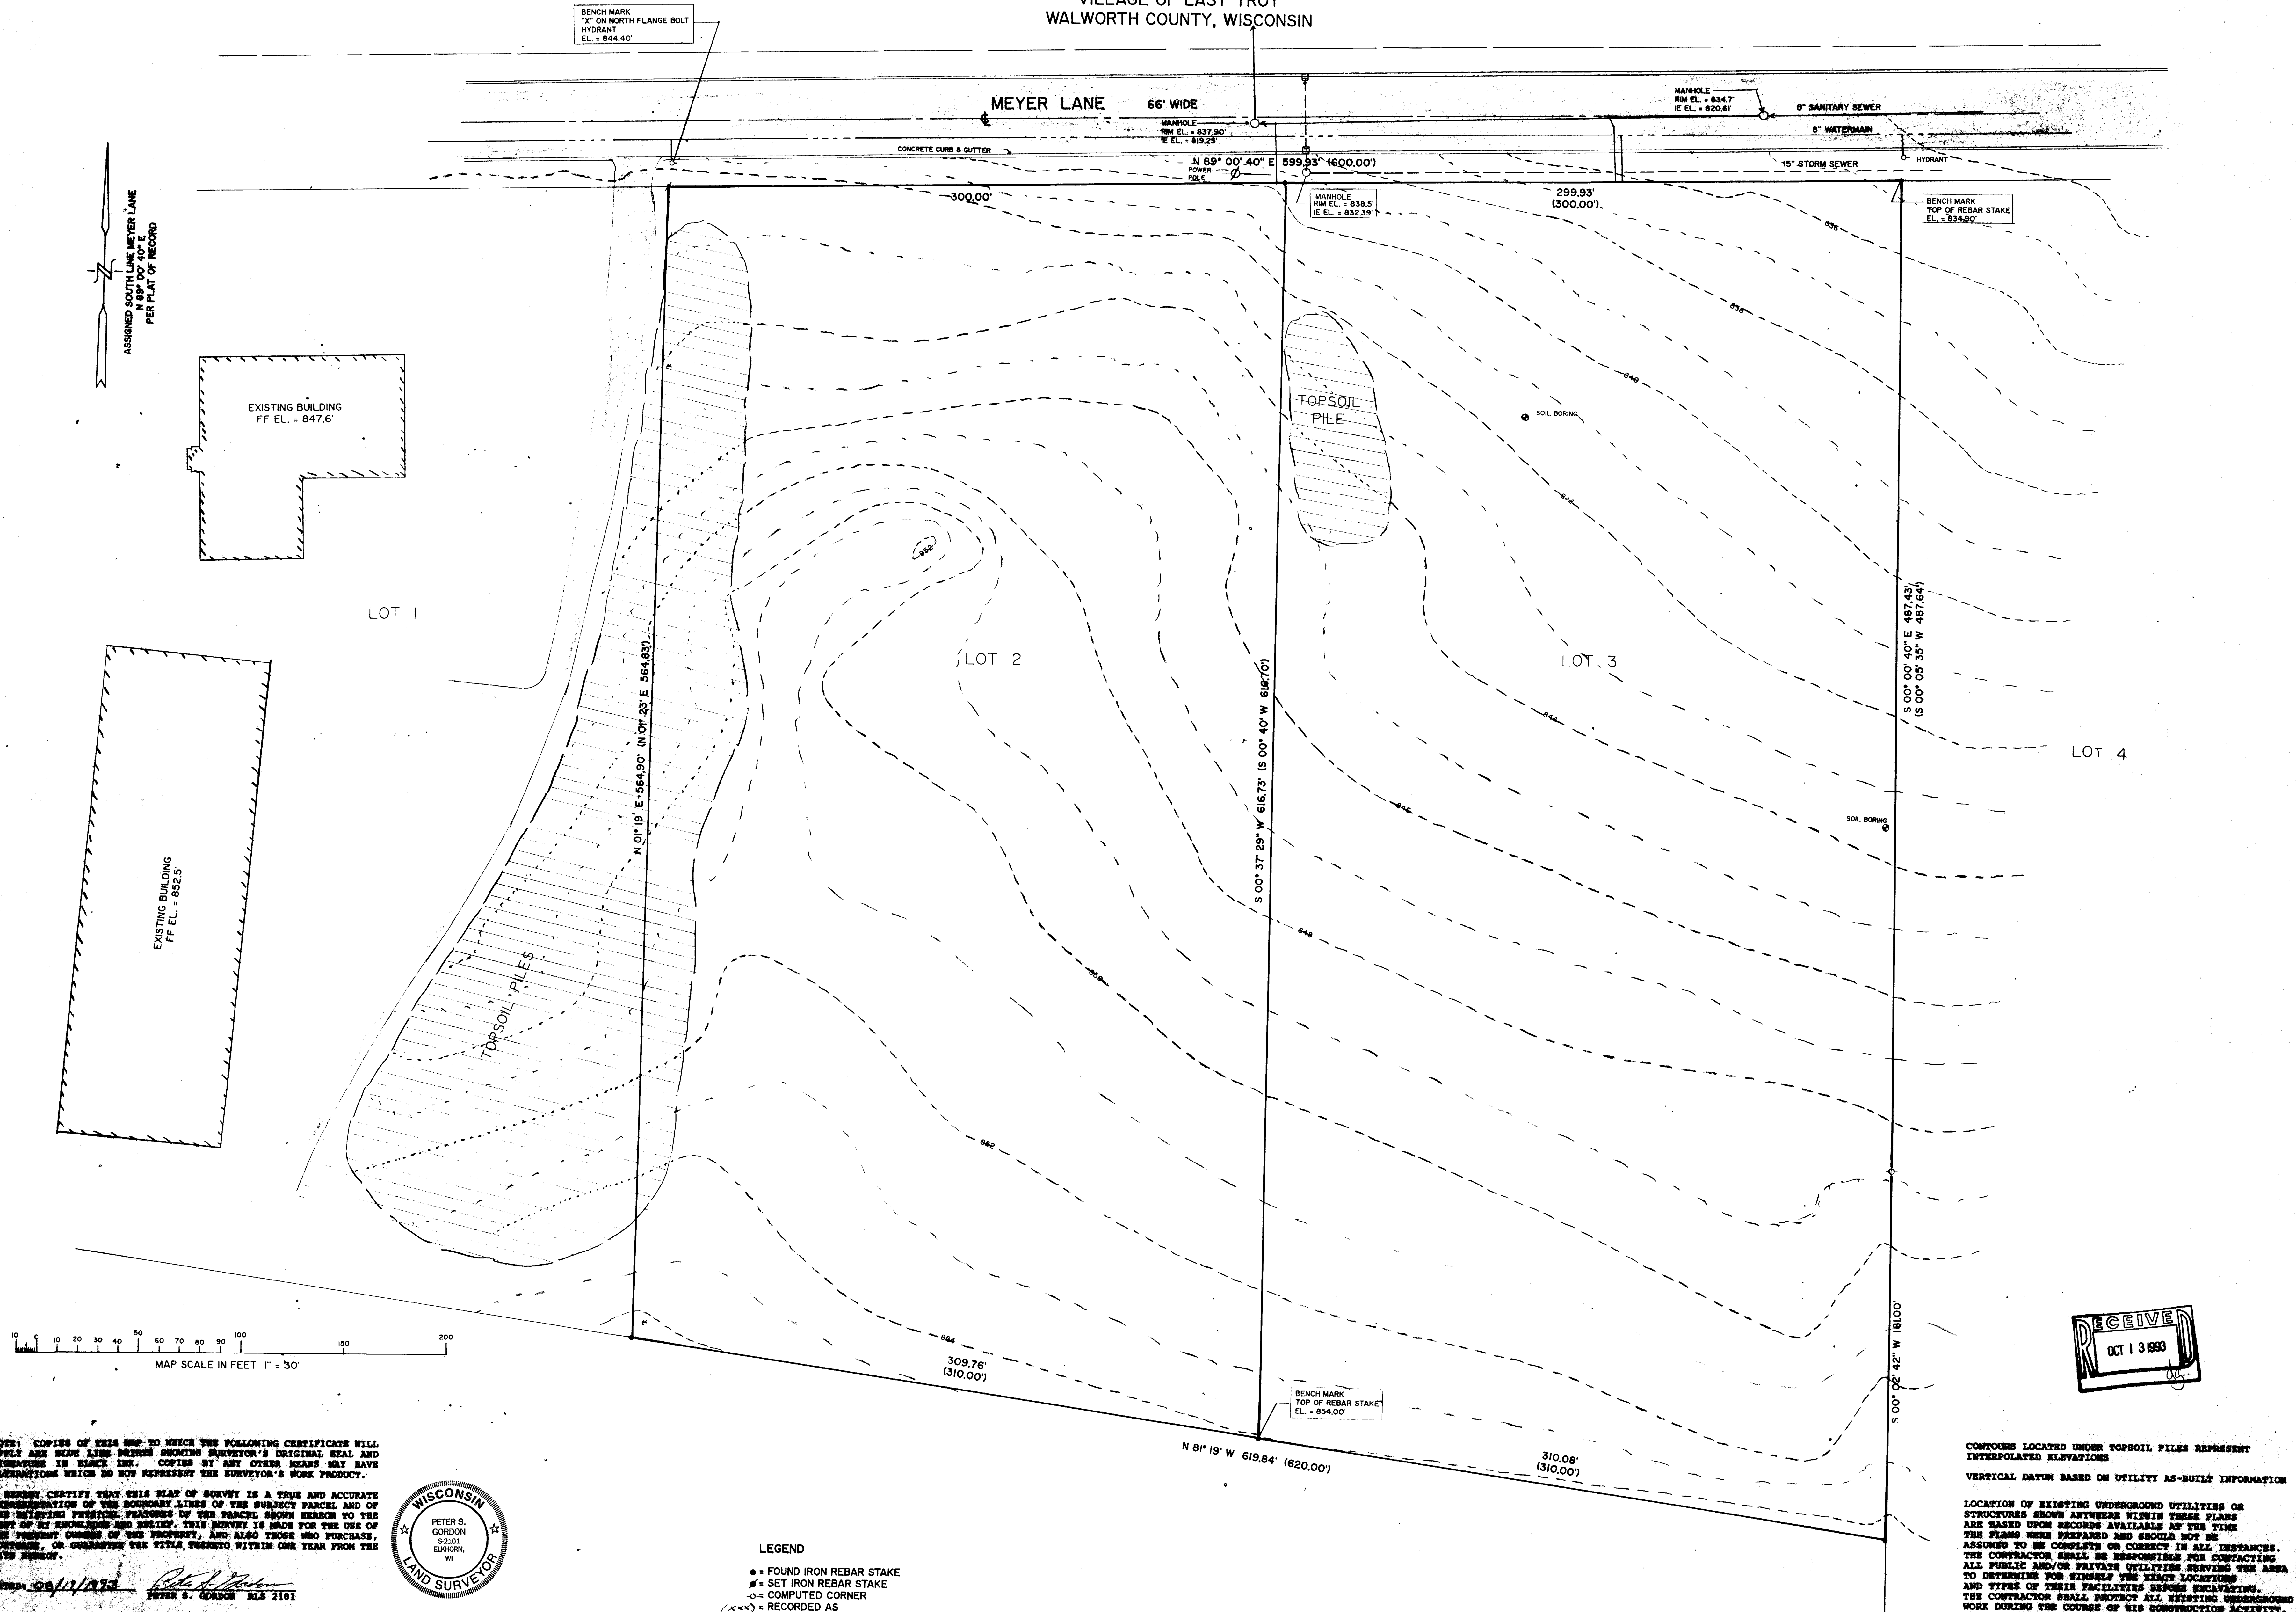

BOUNDARY & TOPOGRAPHIC SURVEY
LOTS 2 & 3 EAST TROY INDUSTRIAL PARK
SEC. 29, TOWN 4 NORTH, RANGE 18 EAST
VILLAGE OF EAST TROY
WALWORTH COUNTY, WISCONSIN

WORK ORDERED BY:
ROGER DIBBLE
VENTURE DEVELOPMENT
W227 N752 WESTMOUND DR. SUITE L3
WALKESSA, WIS.

PARRIS, HANSEN & ASSOCIATES, INC.
Engineering, Architecture & Surveying
7 Ridgeway Court, P.O. Box 237
ELKHORN, WISCONSIN 53121
Office: (414) 723-2888
Fax: (414) 723-8888

REVISIONS

PROJECT NO.
3904
DATE
08/19/93
DRAWN BY
JOF