



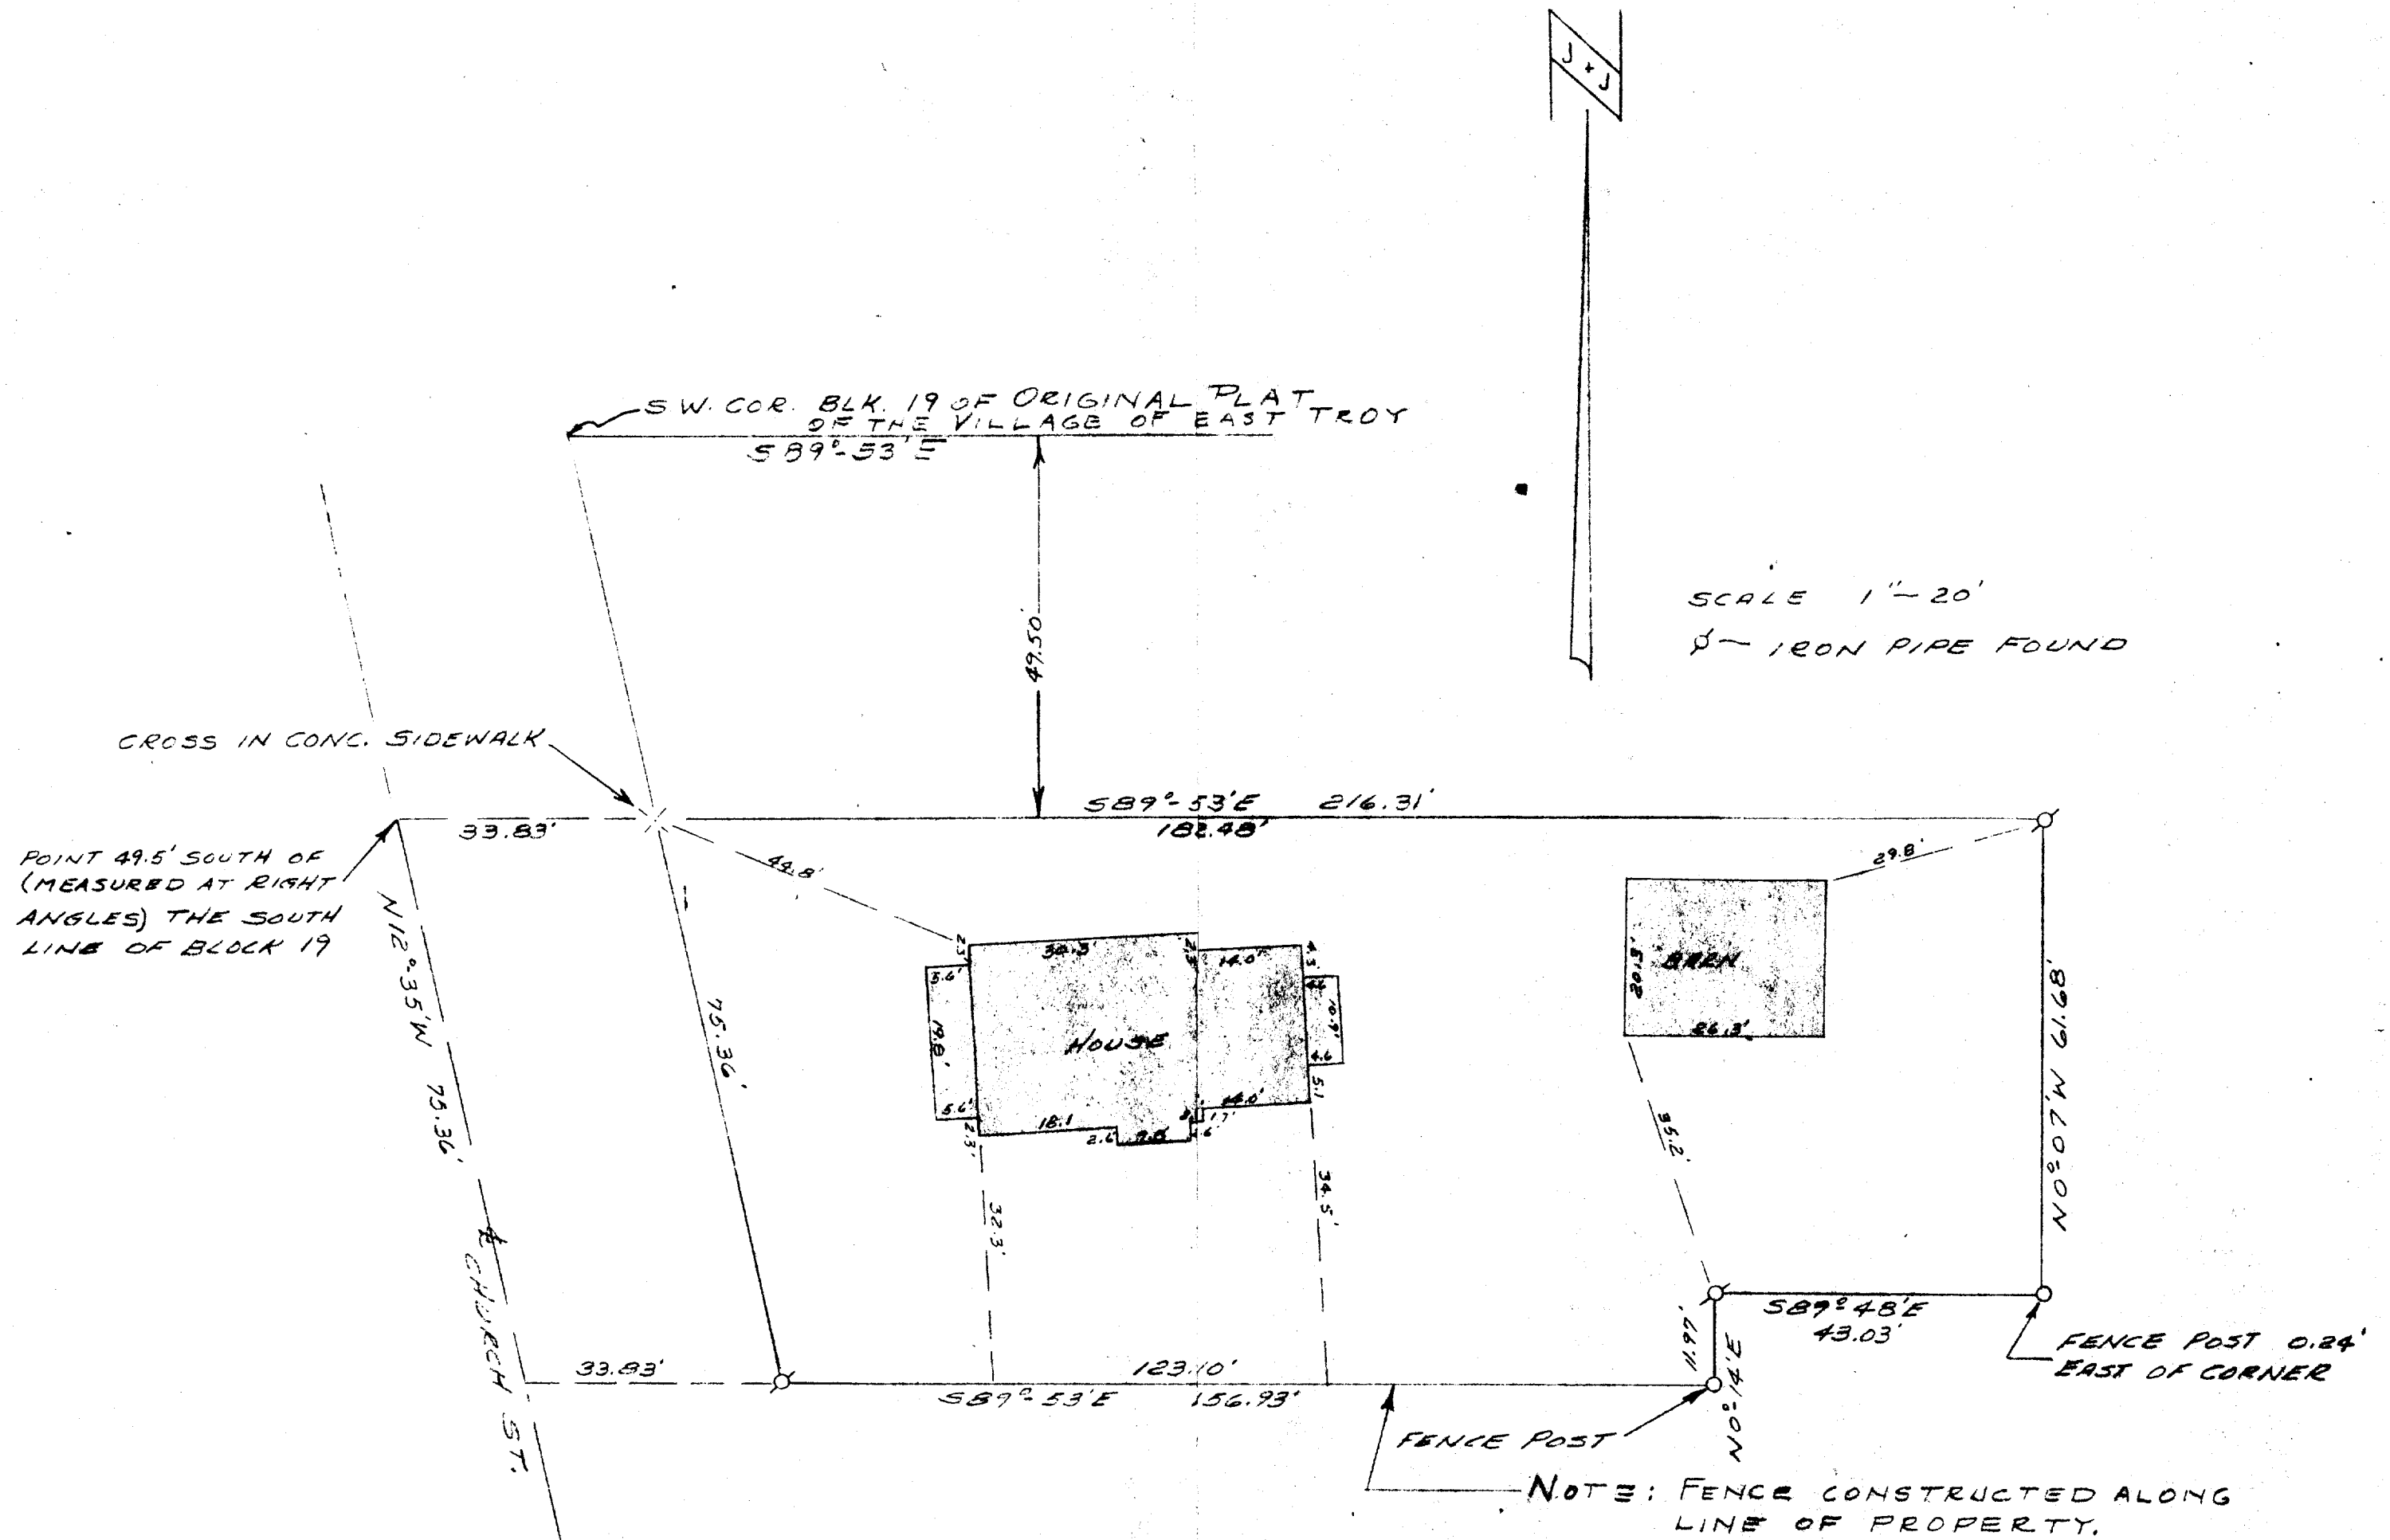

PLAT OF SURVEY
 OF A PARCEL OF LAND LOCATED
 IN THE NW $\frac{1}{4}$ OF SECTION 29,
 T4N R1BE WAL. CO. WIS.

UP-167

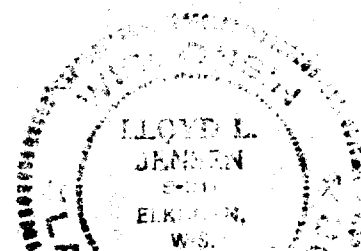

OCT. 8, 1968

Lloyd L. Jensen
 LLOYD L. JENSEN
 CO. SURVEYOR

3-41J