
LOT 2, BLOCK 3, EDWARDS ADDITION TO THE VILLAGE OF EAST TROY, located in Walworth County, Wisconsin.

Survey For: Wayne & Delores Rich Survey Location: 1950 Division Street

## --- DIVISION - STREET

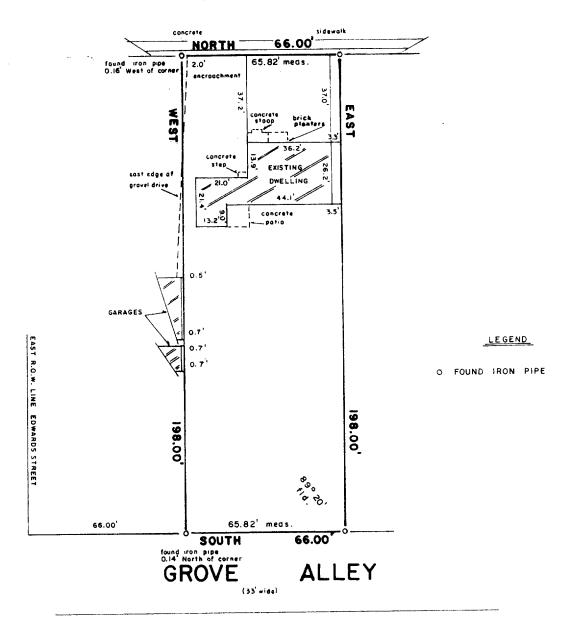



SCALE: 1" = 40



## **B.W. SURVEYING**

Land Surveys
Mapping And Planning
425 Milwaukee Avenue
Burlington, WI 53105
(414) 767-0225

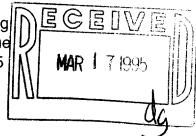

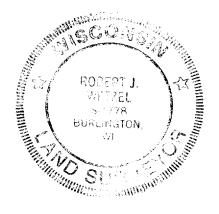

THIS IS NOT AN ORIGINAL PRINT UNLESS THIS SEAL IS RED

"I hereby certify that I have surveyed the above described property and that the above map is a true representation thereof and shows the size and location of the property, its exterior boundaries, the location of all visible structures and dimensions of all principal buildings thereon, boundary fences, apparent easements, roadways and encroachments, if any."

"This survey is made for the use of the present owners of the property , and those who purchase, mortgage, or guarantee the title thereto within one year from the date hereof."  $\Omega$ 

REA-25

ROBERT J. WETZEL
REGISTERED LAND SURVEYOR - 1778

1/3/95 DATE JOB NUMBER

003-442