



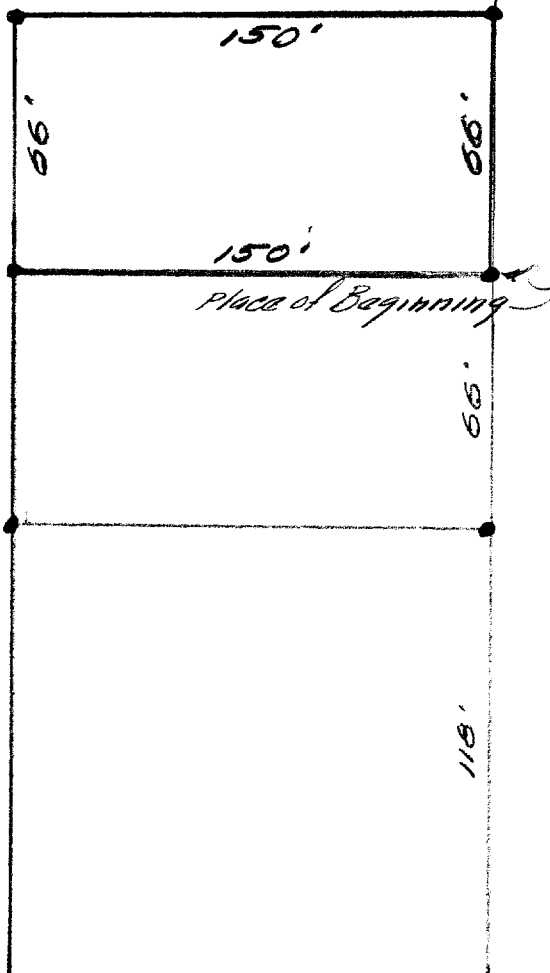

ELM STREET.

W 77

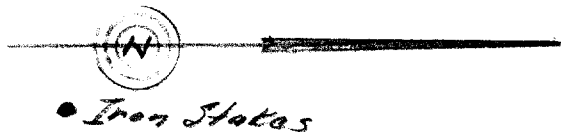

DESCRIPTION: Commencing at a point in the south line of Elm Street in the Village of East Troy, Walworth County, Wisconsin, 448 feet West of the west line of Division St. in said village, thence West along the south line of said Elm Street 66 feet to an iron stake, thence South 150 feet to an iron stake, thence East 66 feet to an iron stake, thence North 150 feet to an iron stake the place of beginning.

Certification: I, hereby certify that I have on this the 17th day of July 1940, surveyed the above described property according to the official records on file in the office of the Recorder of Deeds in and for Walworth County, Wisconsin and find that the measurements and bearings of the boundary lines of said property as taken on this day substantially agree with those in the above description and that no encroachments exist.

SIGNED AND SEALED THIS 15TH DAY OF JULY 1940.

Joseph M. Bragi
Joseph M. Bragi
Elkhorn Wisconsin.

DIVISION

ST.