
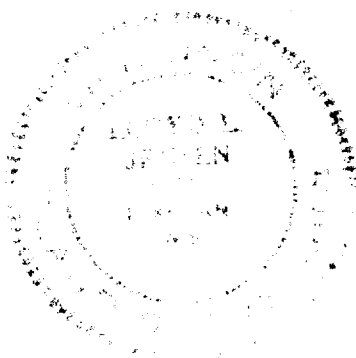


PLAT OF SURVEY OF

LOT 5 BLOCK 1 NORTH VIEW ADDITION
TO THE VILLAGE OF EAST TROY, SECTION 19,
TAN RIBE W/ALNORTH COUNTY, WISCONSIN.

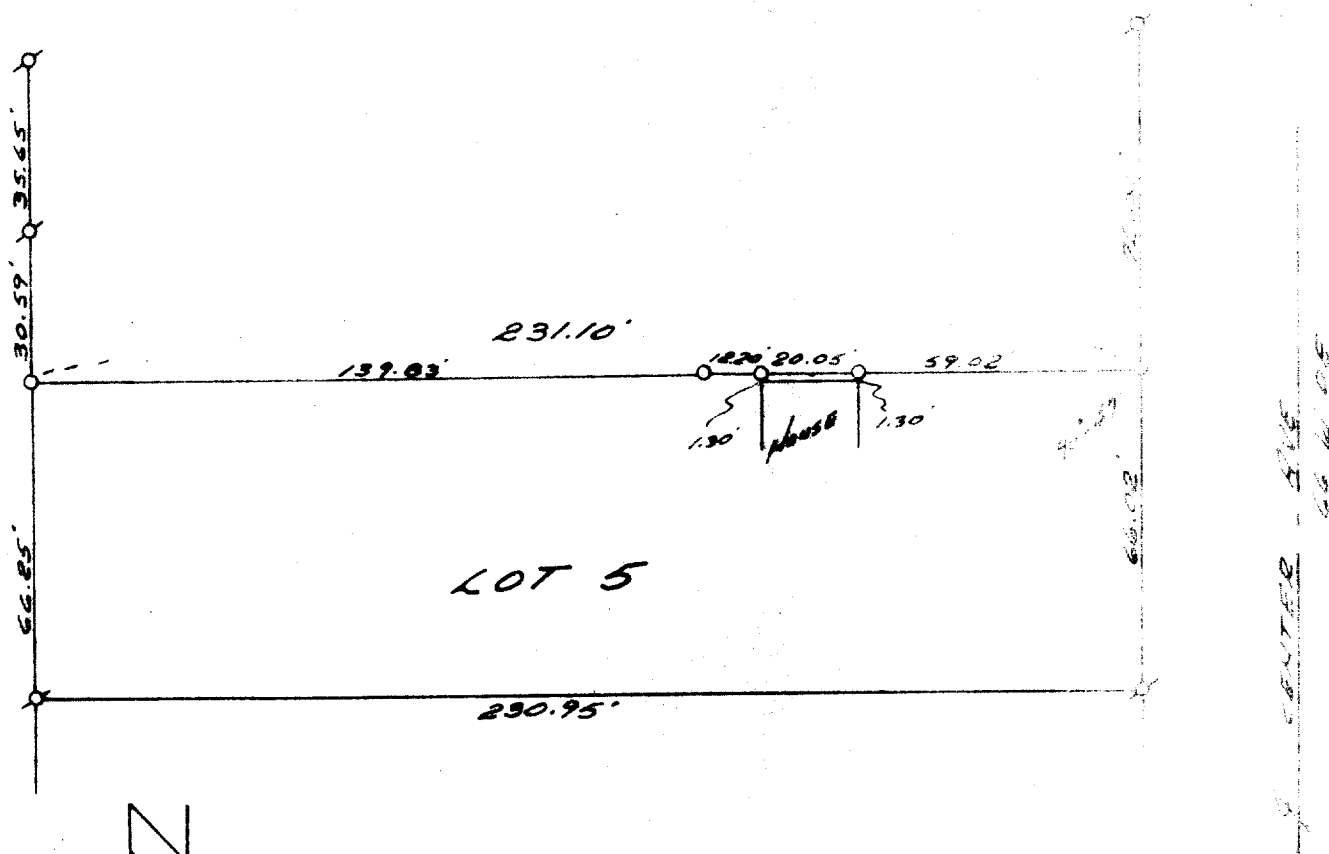

SURVEY AND PLAT BY
JENSEN & JOHNSON, INC.
CIVIL ENGINEERS AND SURVEYORS

Elkhorn, Wisconsin

LEGEND

- — Iron Pipe SET
- — Concrete Monument

Scale 1" = 40'

Δ — IRON ROD FOUND

WE CERTIFY: That we have surveyed the above described property and that the plat shown hereon is an accurate survey and a true representation thereof and correctly shows the exterior boundary lines and all divisions of said property.

Date APRIL 9, 1971

LLOYD L. JENSEN

Wisconsin Registered Land Surveyor, No. S-211