

# HOLLAND & THOMAS, L.L.C. - LAND SURVEYORS

202 West Street Johnson Creek, WI 53038 (920) 699-3305

A B C D E F G

## PLAT OF SURVEY

FOR LOT 11 OF CRYSTAL ACRES, PART OF THE NW 1/4 AND NE 1/4 OF THE  
SOUTHWEST QUARTER OF SECTION 20, TOWN 4 NORTH, RANGE 18 EAST,  
VILLAGE OF EAST TROY, WALWORTH COUNTY, WISCONSIN.

### BROOKS COURT

STM. MH

(66' R-O-W)

BACK OF CURB

N 88°-45'-50" E 60.00'

NAIL FOUND

25.0'

TEMP. #3

STONE

DRIVE

21.88'

11.62'

4.26'

5.42'

12.26'

2.92'

1.18'

18.40'

10.0'

10.4'

1.91'

1.96'

4.92'

1.49'

33.85'

17.60'

7.95'

25.5'

25.0'

63.5'

12.0'

20.0'

10.0'

10.0'

LOT 12

N 01°-14'-10" W 130.00'

LOT 11  
10,314 S.F.

BUILDING UNDER  
CONSTRUCTION

12' UTILITY

20' PUBLIC

EASEMENT

EASEMENT

FOR STORM SEWER AND DRAINAGE

N 88°-45'-50" E 80.00'

LOT 10

EXISTING TOP OF FOUNDATION: 842.28

NOTE: FINAL LOT CORNERS BY OTHERS.


IF THE SURVEYOR'S SEAL IS NOT  
RED, THE PLAN IS A COPY THAT  
SHOULD BE ASSUMED TO CONTAIN  
UNAUTHORIZED ALTERATIONS. THE  
CERTIFICATION CONTAINED ON THIS  
DOCUMENT DOES NOT APPLY TO  
COPIES UNLESS THEY TOO HAVE A  
RED STAMP OVER THE PHOTOCOPIED  
STAMP BY SAME SURVEYOR.

State of Wisconsin } SS.  
County of Jefferson }

We, Holland & Thomas, L.L.C., do hereby certify that we have made this survey and that the information as shown on the above  
Plat of Survey is a true and correct representation thereof.

C1  
RAD = 20.00'  
ARC = 31.42'  
CHD = 28.28'  
BEARING = N 46°-14'-10" W


BEARINGS ARE REFERENCED TO THE WEST LINE OF  
THE SOUTHWEST QUARTER OF SECTION 20-4-18,  
WHICH IS ASSUMED TO BEAR N 00°-13'-59" W.

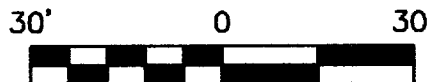

### LEGEND: These standard symbols may be found in the drawing.

- Lot Corner (Found) w/desc.
- ⊥ Lateral End
- Utility Pedestal
- Catch Basin
- ⊗ Water Valve
- ⊕ Man Hole w/type
- Easement Boundary
- Setback Line

BUILDER: BROOKSTONE HOMES, INC.  
1860 EXECUTIVE DRIVE  
SUITE B1  
OCONOMOWOC, WI 53066  
PH: (262) 567-5700  
FAX: (262) 567-7228

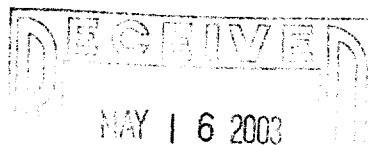

KW

003-851

RCRA-11