

W 238 S 3712 BIG BEND ROAD
WAUKESHA, WIS 53186

TELEPHONE
542-5616

RONALD H. ZIMMERMAN
REGISTERED LAND SURVEYOR

PLAT OF SURVEY

FOR


WAUKESHA SAVINGS & LOAN

SOUTH STREET

CT.

SHORES

WILLOW

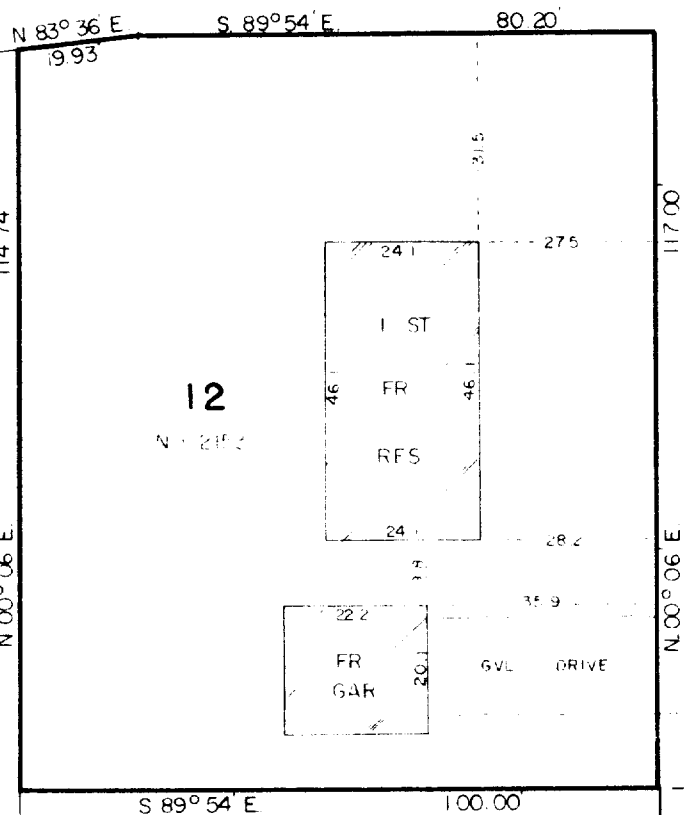

13

SCALE
1" = 30'

CERTIFICATION

STATE OF WISCONSIN
COUNTY OF WAUKESHA

I, RONALD H. ZIMMERMAN, REGISTERED LAND SURVEYOR, DO HEREBY CERTIFY THAT I HAVE MADE A SURVEY
OF LOT 12, WILLOW SHORES SUBD., VILLAGE OF EAST TROY,
AND THE EXISTING BUILDING AND IMPROVEMENTS LOCATED THEREON AND THAT THE PLAT HERewith DRAWN
IS A CORRECT REPRESENTATION OF SAID SURVEY

DATE DEC 5, 19 73

RONALD H. ZIMMERMAN

3-88