
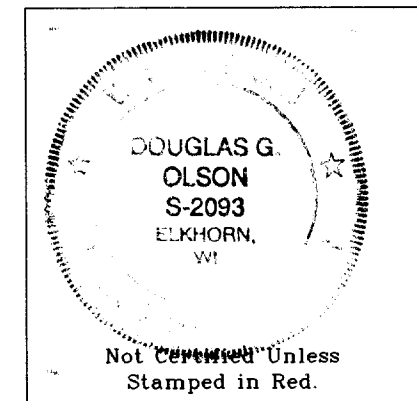
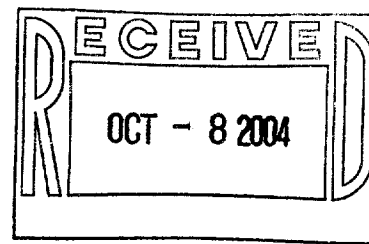


Plat of Survey

A parcel of land described in a Special Warranty Deed recorded in Vol. 662 on Page 2968 as Document No. 410687, as shown below:

Part of the Northeast One-quarter (1/4) of Section Thirty (30), in Township Four (4) North, Range Eighteen (18) East, in the Village of East Troy, County of Walworth, State of Wisconsin, bounded and described as follows: Commencing at a stake in the center of the Milwaukee and Beloit Road 8 rods and 4 feet West of the Northwest corner of lands owned by Keats Brothers on Section Thirty (30), in Township Four (4) North, Range Eighteen (18) East and running thence in a Westerly direction along the center line of said highway 6 rods and 2 feet, thence South 15 rods; thence East 6 rods and 2 feet, thence North to the place of beginning.

Surveyed for: **American Classic Properties, Inc.**
2068 Division Street
East Troy, Wisconsin. 53120

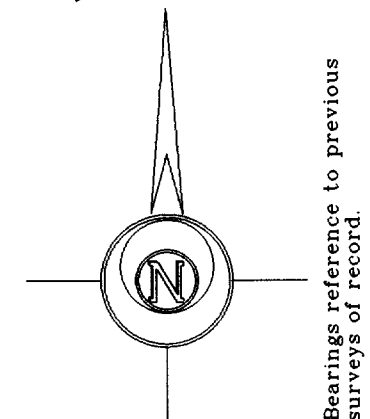

- Notes: 1) This survey plat is not certified unless signed and sealed in red ink.
- 2) This survey is subject to Wisconsin lien laws. This Plat of Survey is the notice of intent to file lien. Lien waiver required.

Copyright © 2004 by Jensen & Olson Land Surveying, LLC.


All rights reserved. No part of this survey plat may be reproduced or transmitted in any form by any means - graphic, electronic, or mechanical, including photocopying, tracing, or information storage and retrieval systems - without permission in writing from Douglas G. Olson, Jensen & Olson Land Surveying, LLC.

I hereby certify that I have surveyed the above described property and the map hereon is correct to the best of my professional knowledge and belief and shows the size and location of the property, its exterior boundaries, the location and dimensions of all visible structures thereon, boundary fences, apparent easements and roadways and visible encroachments, if any.

This survey is made for the exclusive use of the present owners of property, and also those who purchase, mortgage or guarantee title thereto, within one year from the date hereof.

Douglas G. Olson
Wisconsin Registered Land Surveyor - 2093

Survey Date: October 6, 2004.
Revisions:

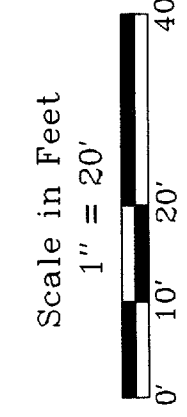

Jensen & Olson Land Surveying, LLC
45 South Wisconsin Street
Elkhorn, Wisconsin. 53121
Telephone (262) 723-3434
Facsimile (262) 723-8044

Legend
X Found Iron Pipe
() Recorded Information
X Utility Pole
X Concrete Surface
X Asphalt Surface
X Gravel Surface

Sheet 1 of 1 Sheets
Job Reference Number
2004.161

2004.161

RXUP 00185

003-885