

PLAT OF SURVEY

BADGER SURVEYING CO., INC.

7970 NORTH 47TH ST.

BROWN DEER, WISCONSIN 53223

PHONE 354-9080

CLARENCE H. PIEPENBURG, PRESIDENT
REGISTERED LAND SURVEYOR

41P-800



PROPERTY AT

413 Main Street

Robert E. Billings

OWNER.

LEGAL DESCRIPTION — A parcel of land located in the North West 1/4 of the North East 1/4 of Section 30, Township 4 North, Range 18 East, in the Village of East Troy, Walworth County, Wisconsin, described as follows, to-wit: Commencing at the intersection of the centerline of State Trunk Highway 15 (Main Street) and the North-South 1/8 Section line of said North East 1/4; thence S.81° 00' W. along said centerline 637.27 feet to the place of beginning; thence S.0° 04' W. parallel with said 1/8 Section line 247.50 feet; thence S.81° 00' W. 91.25 feet; thence N.0° 04' E. parallel with said 1/8 Section line 247.50 feet to the centerline of said Highway 15; thence N.81° 00' E. along said centerline 91.25 feet to the place of beginning.

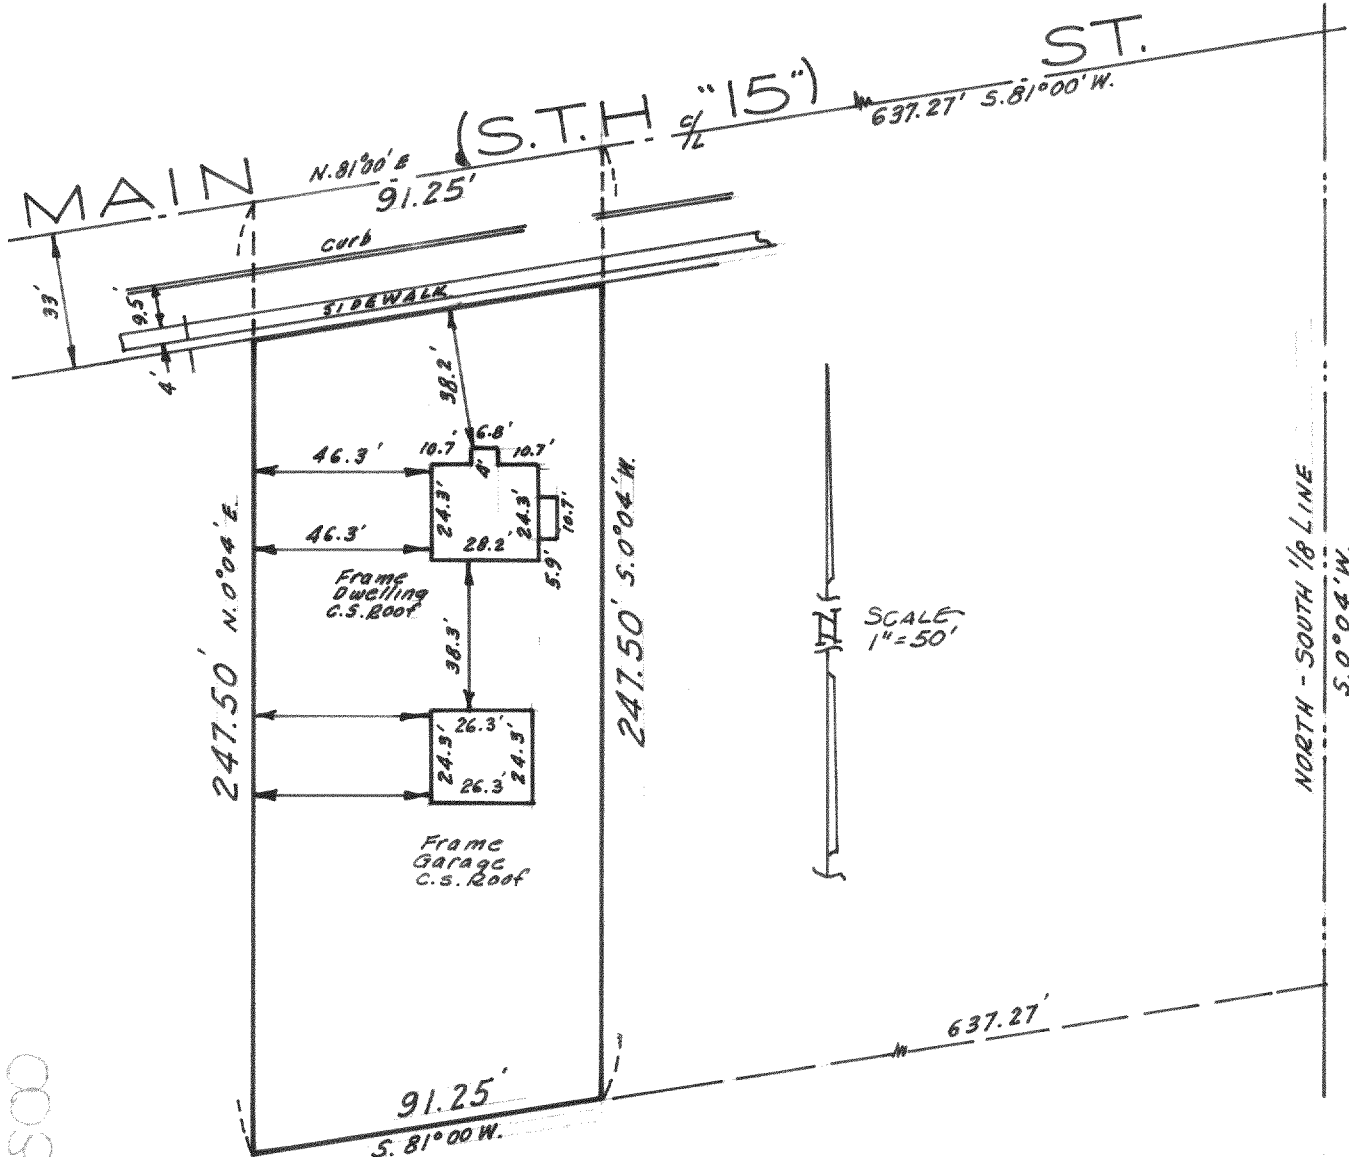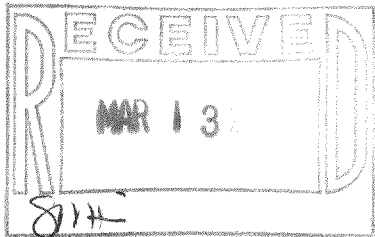

Prepared for SECURITY S/L ASSN.

State of Wisconsin, {
County of Milwaukee } ss.

I hereby certify that on the 14TH day of AUGUST, 1970, I have accurately surveyed the above described property and that the above plat is a correct representation thereof and shows the exterior boundary lines and location of buildings and other improvements on said property and the correct measurements thereof.

Signed Clarence H. Piepenburg
Registered Land Surveyor

Plat No. 70-364

RXUP-187

003-914

41P-800