



Plat of Survey

of

Lot 23 of Sterling Oaks,

a subdivision located in the Northeast 1/4 of Section 20, Town 4 North, Range 18 East, Village of East Troy, Walworth County, Wisconsin.

Surveyed for: **Bob Strzelecki**
1812 Kettle Court
East Troy, Wisconsin. 53120

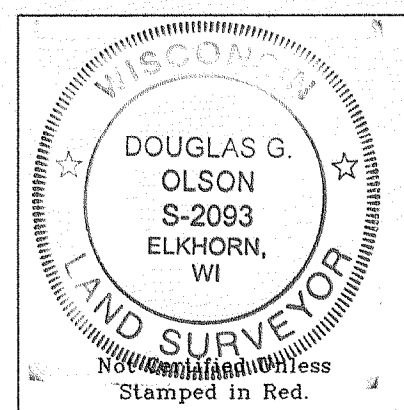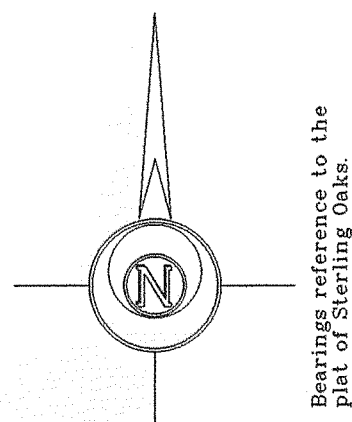

- Notes: 1) This survey plat is not certified unless signed and sealed in red ink.
- 2) This survey is subject to Wisconsin lien laws. This Plat of Survey is the notice of intent to file lien. Lien waiver required.

Copyright © 2006 by Jensen & Olson Land Surveying, LLC.

All rights reserved. No part of this survey plat may be reproduced or transmitted in any form by any means - graphic, electronic, or mechanical, including photocopying, tracing, or information storage and retrieval systems - without permission in writing from Douglas G. Olson, Jensen & Olson Land Surveying, LLC.

I, Douglas G. Olson, Wisconsin Registered Land Surveyor, do hereby certify that this survey was performed by me or under my direction in full compliance with the owner's/agent's instructions and Chapter A-E 7 of the Wisconsin Administrative Code "Minimum Standards for Property Surveys", and that this map is an accurate representation thereof to the best of my knowledge and belief.


Douglas G. Olson
Wisconsin Registered Land Surveyor - 2093



Curve 1
 $\Delta=45^{\circ}34'43''$ $45^{\circ}34'23''$
 $R=30.00'$
 $L=23.86'$ (23.862')
 $Chb=S72^{\circ}11'17''W$ (N72^{\circ}11'07.5"E)
 $Ch=23.24'$ (23.238')

Curve 2
 $\Delta=34^{\circ}10'29''$
 $R=60.00'$
 $L=35.79'$ (35.788')
 $Chb=S77^{\circ}52'41''W$ (N77^{\circ}53'04.5"E)
 $Ch=35.26'$ (35.259')

Survey Date: May 17, 2006.
Revisions:

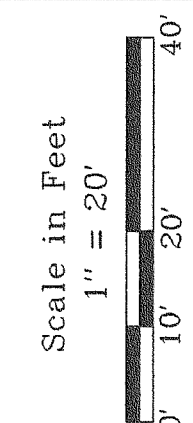


Jensen & Olson Land Surveying, LLC
45 South Wisconsin Street P.O. Box 322
Elkhorn, Wisconsin. 53121
Telephone (262) 723-3434
Facsimile (262) 723-8044

Legend
Found Iron Pipe
Set Iron Rod
Set Masonry Nail
Set Chiseled Cross
Recorded Information
Utility Pedestal
Water Valve
Asphalt Surface
Concrete

Sheet 1 of 1 Sheets
Job Reference Number
2006.063

2006.063

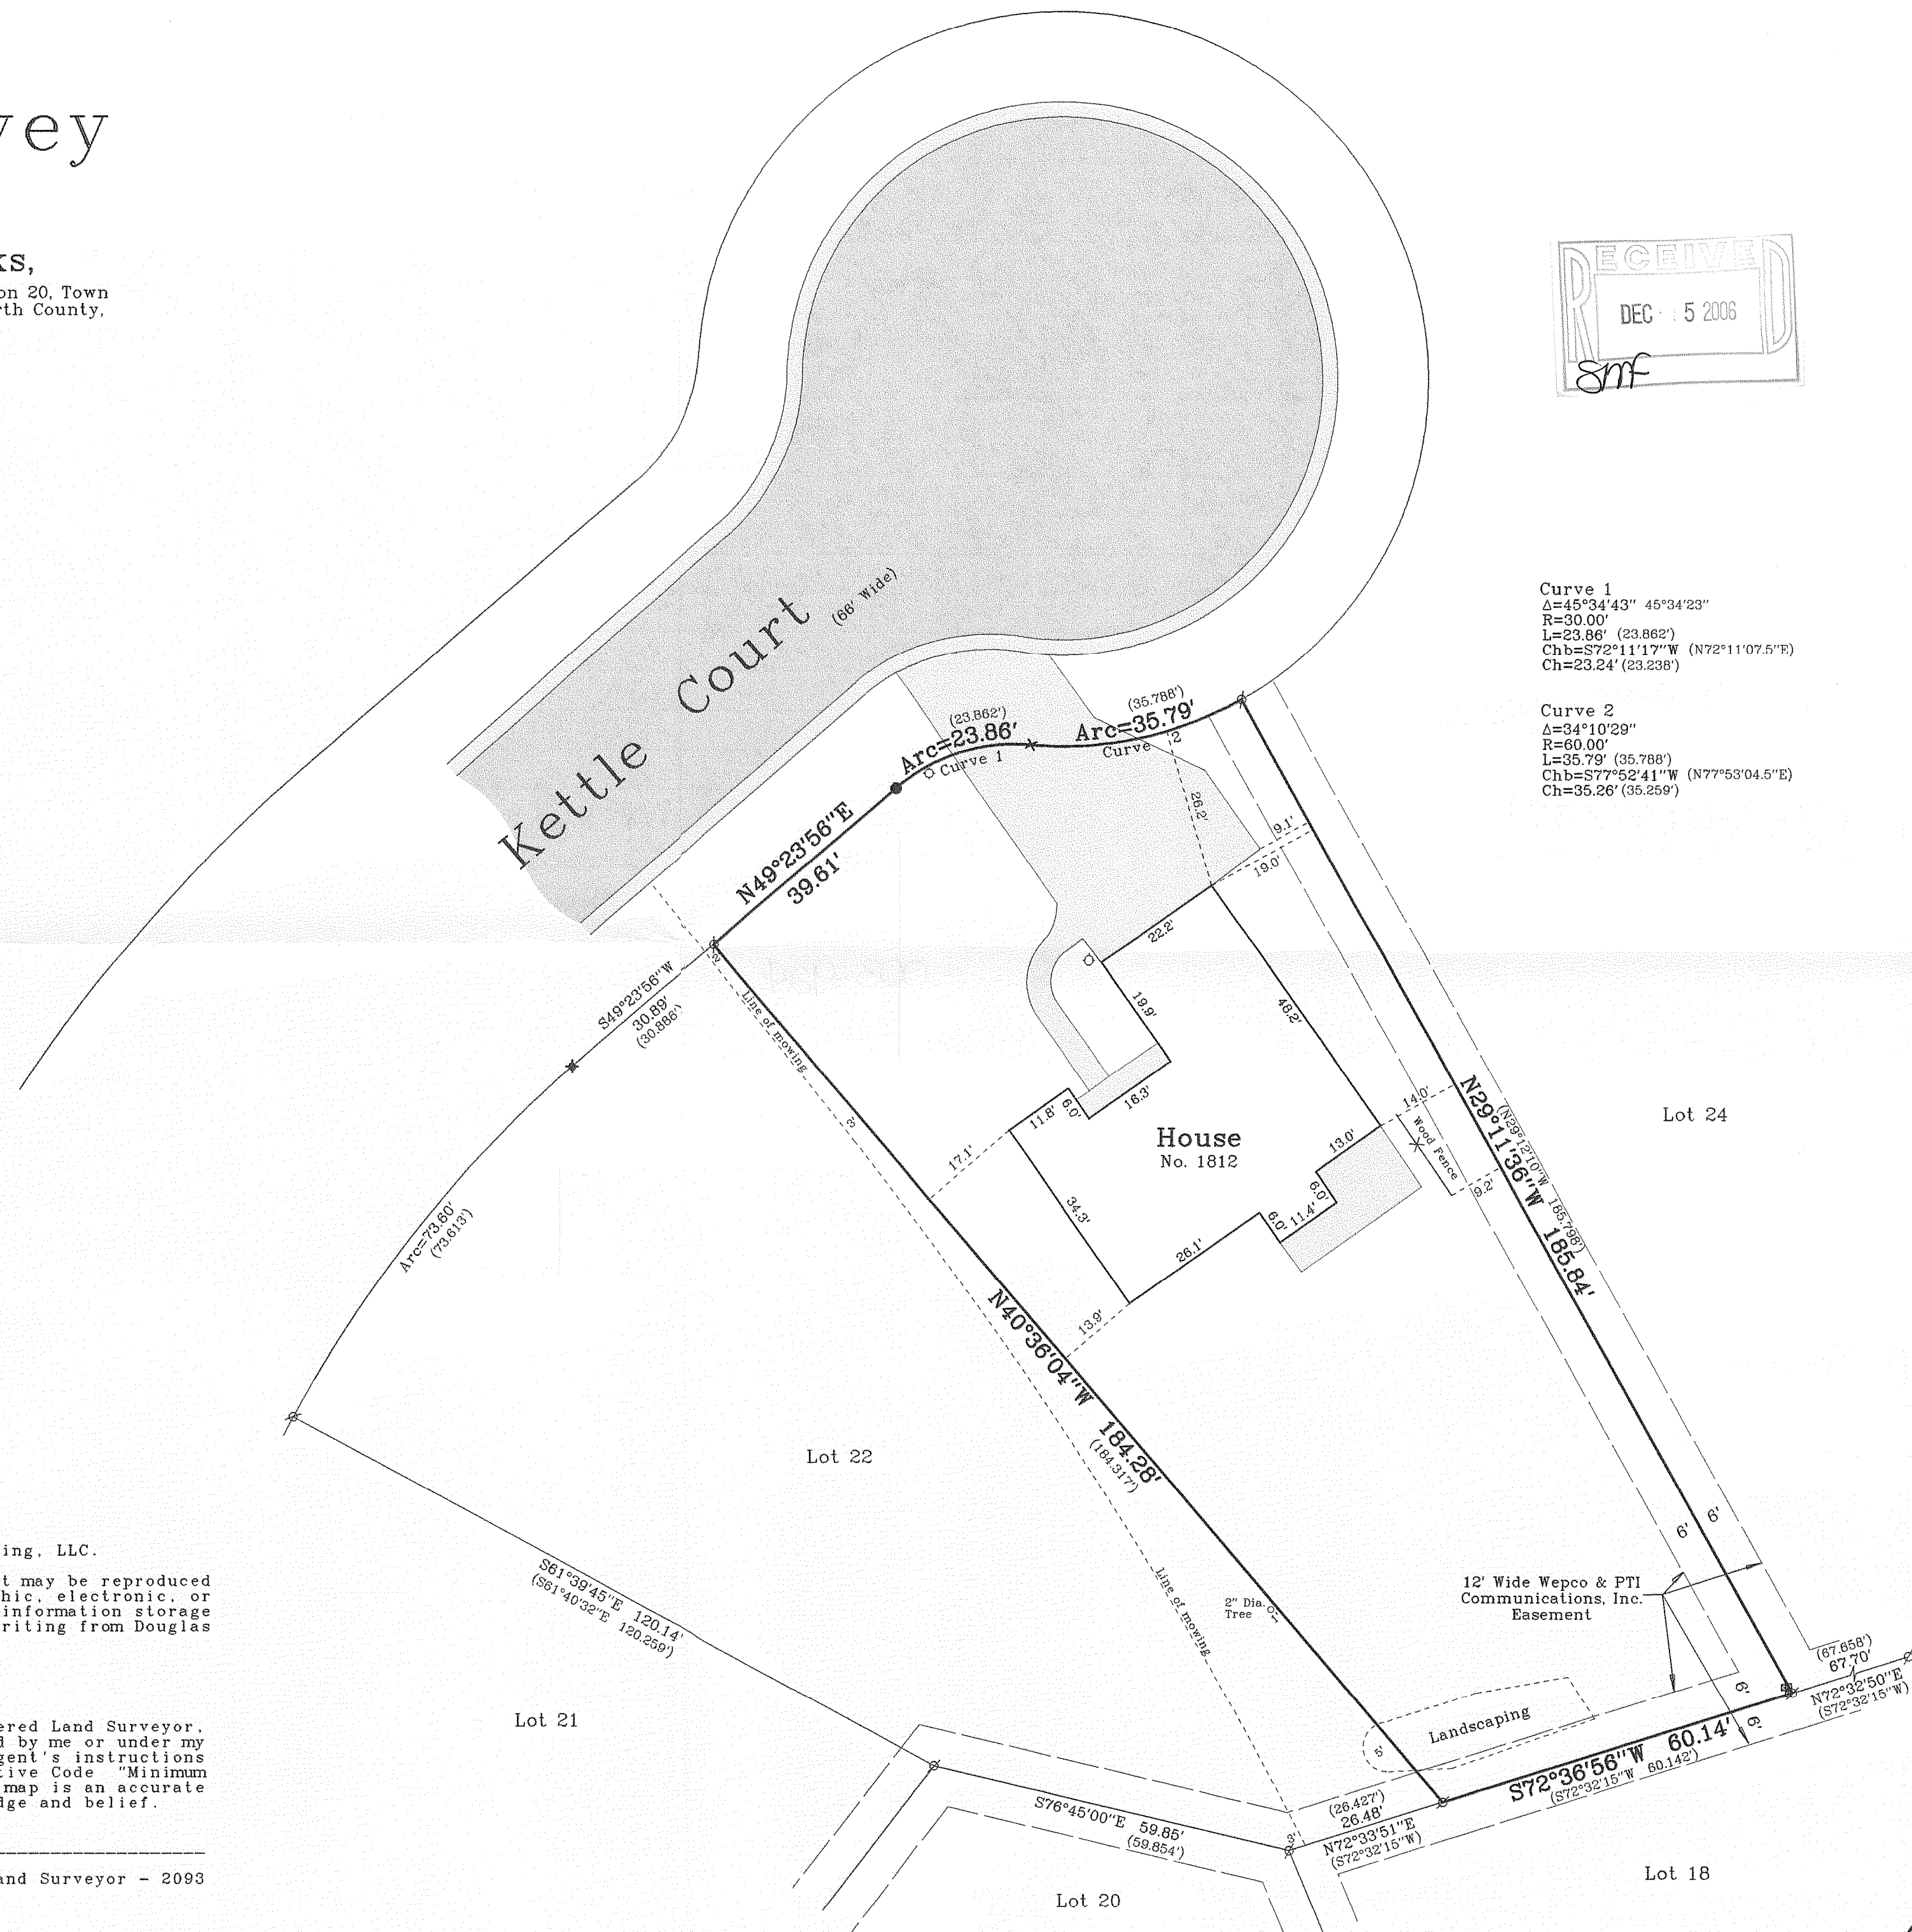

RSTO-23

003-924