


Lot 2, Block 2 of NORTH VIEW ADDITION TO THE VILLAGE OF EAST TROY being a subdivision of part of the Northeast Quarter of the Southeast Quarter of Section 19, Township 4 North, Range 18 East of the 4th Principal Meridian, Village of East Troy, Walworth County, Wisconsin.

Parcel Identification Number: RNV 00011

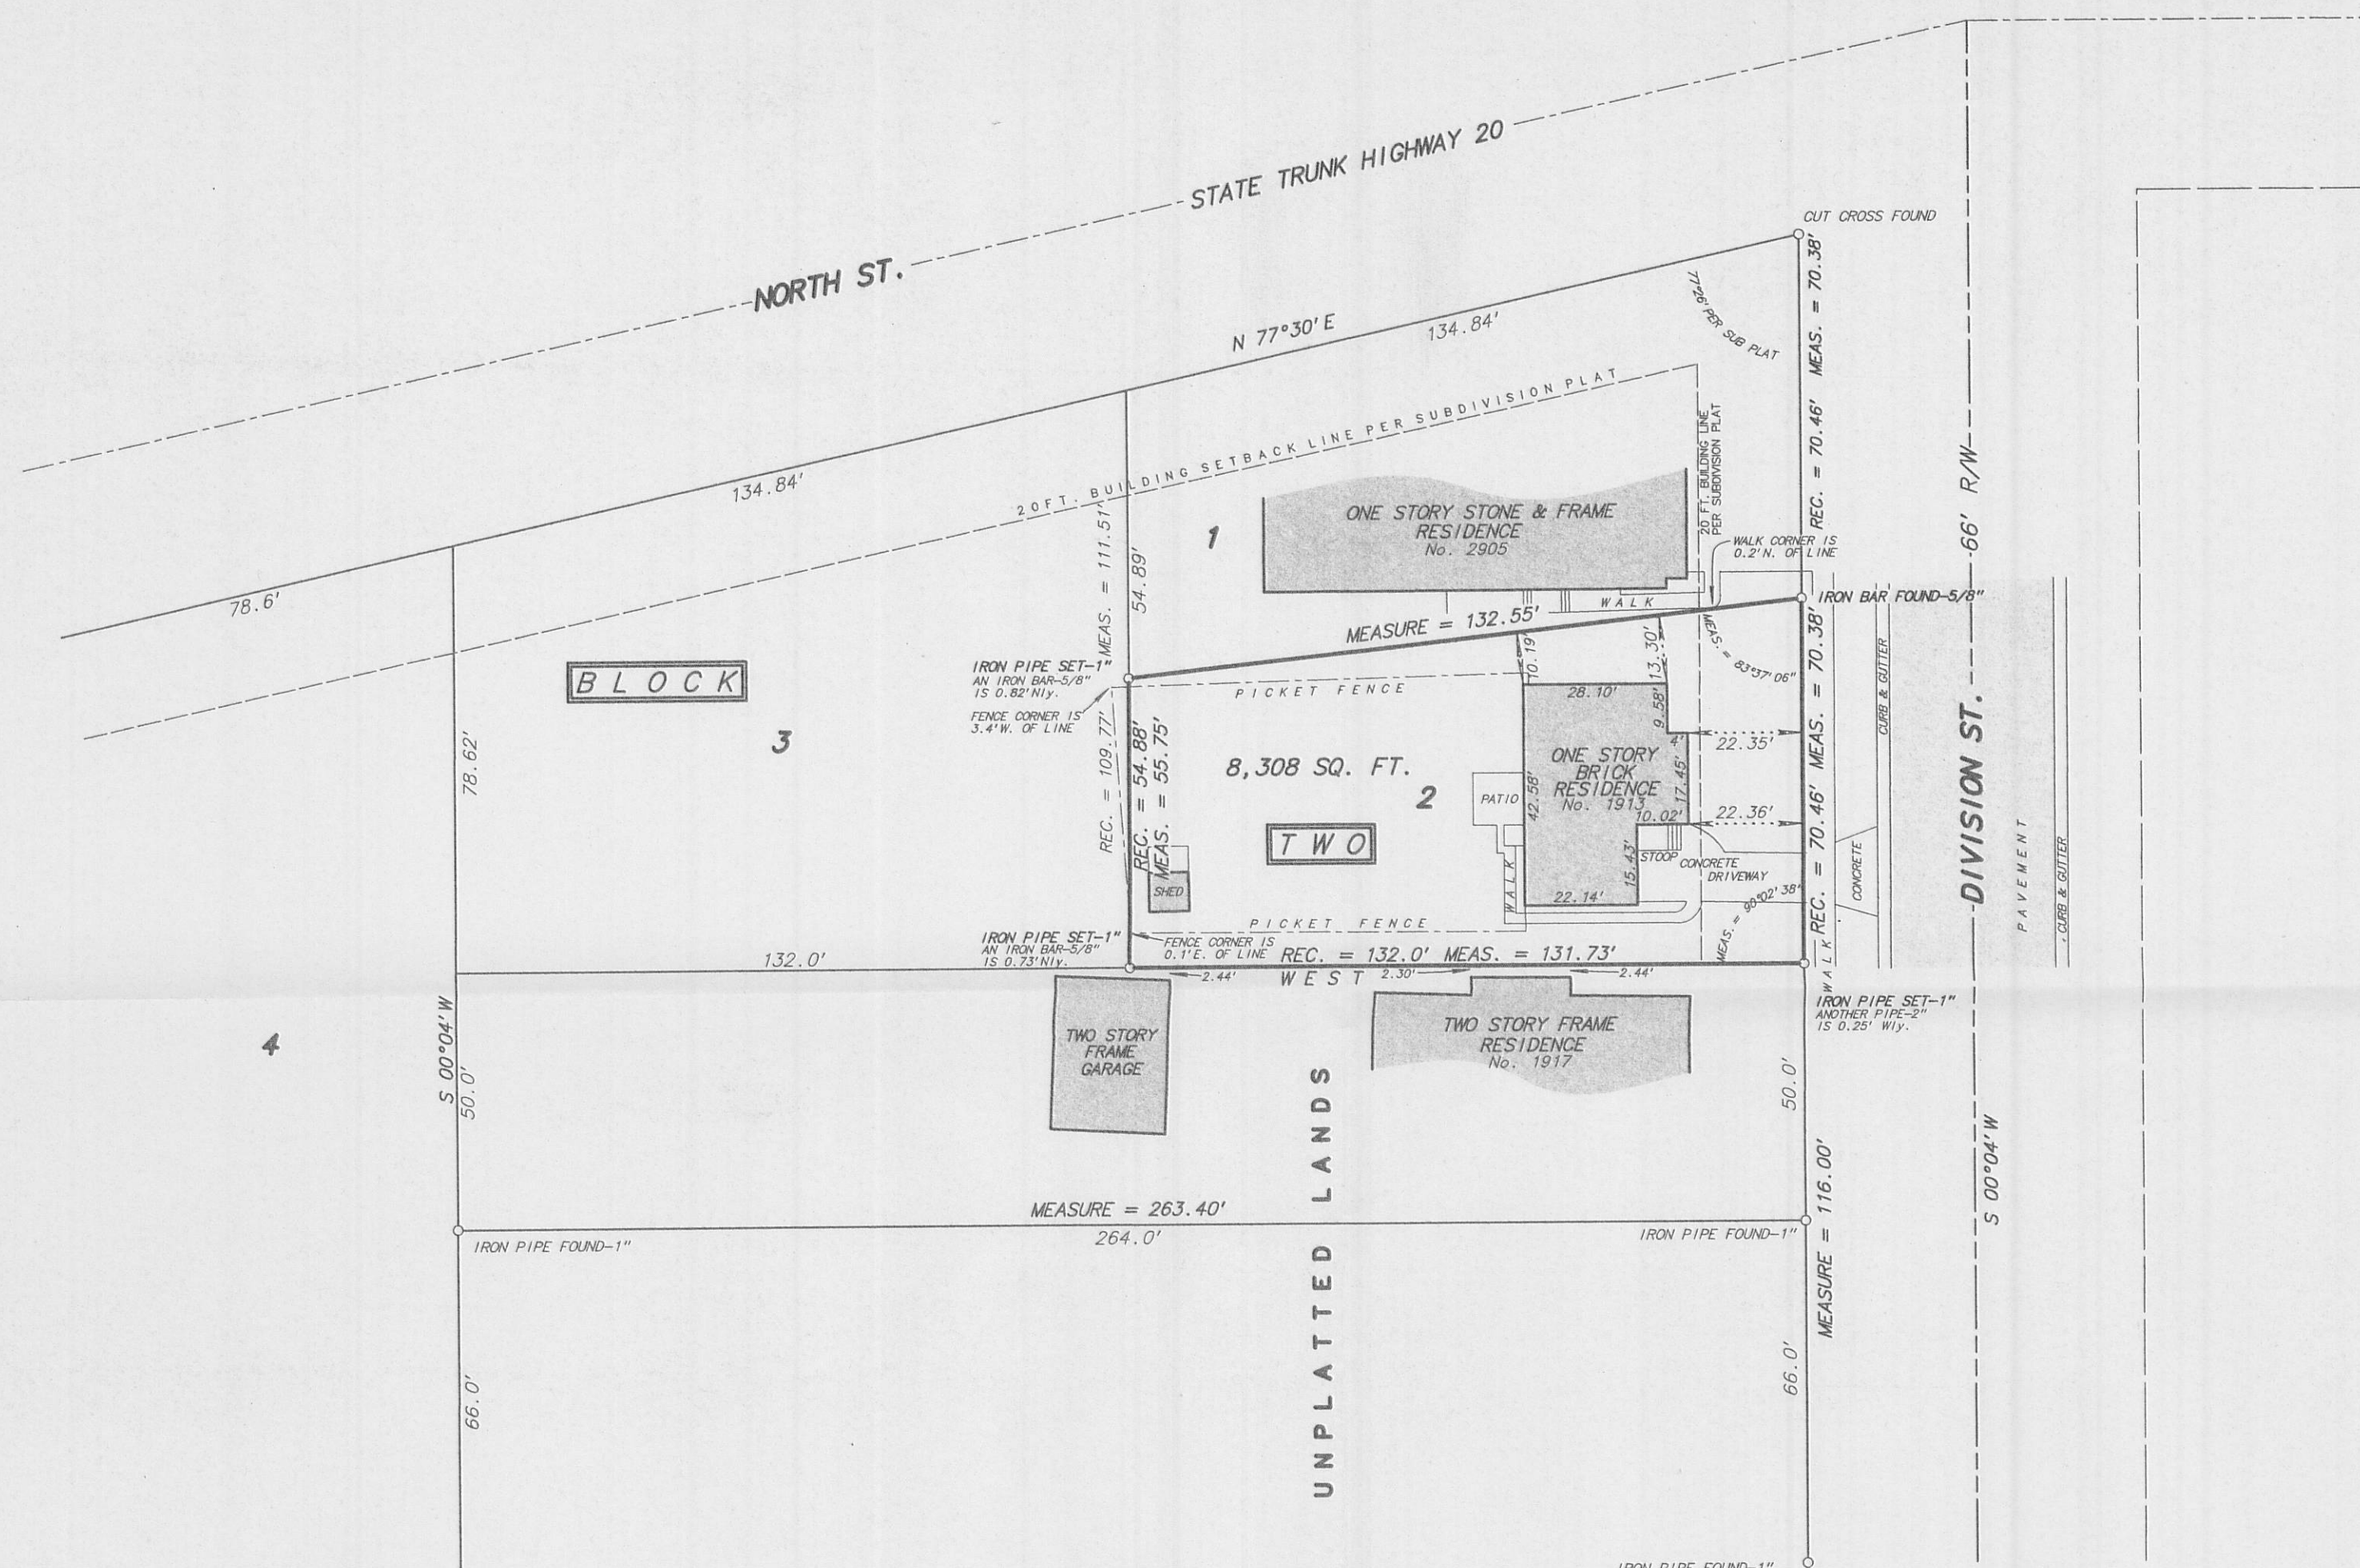

RECEIVED
MAY 05 2010
By SMF
Rec'd Unsigned

Fieldwork completed on and date of certification: May 10, 2007

I, hereby certify that I have surveyed the above described property and the above plat is a true and correct representation thereof and shows the size and location of the property, its exterior boundaries, the location and dimensions of all visible structures thereon, boundary fences, apparent easements and roadways and visible encroachments, if any.

This survey is made for the exclusive use of the present owners of the property and also those who purchase, mortgage or guarantee the title thereto within ONE YEAR from the date hereof.

Dated at Bassett, Wisconsin this _____ day of _____, 2007.

SCALE: 1 inch = 30 feet
ORDERED BY: S. Seager
JOB NO. 07099

RNV-11

003-976

Mark A. Bolender
Wisconsin Registered Land Surveyor S - 1784