

# PLAT OF SURVEY

LOT 8 OF MOORE'S VILLAGE SHORES LOCATED IN THE SW. 1/4 OF THE  
NW. 1/4 OF SECTION 29, T.4N., R.18E., VILLAGE OF EAST TROY,  
WALWORTH COUNTY, WISCONSIN.

## ATLAS SURVEY


2826 ST. ANDREWS CT.  
WAUKESHA, WI 53188  
(262) 901-5256  
INFO@ATLASSURVEYWI.COM  
WWW.ATLASSURVEYWI.COM

SURVEYOR:  
BRYCE KACZOR, RLS S-2803  
SURVEY FOR:  
DANA & COLLEEN TOPPLE  
2190 NORTH SHORE DRIVE  
EAST TROY, WI 53120

### LEGEND


- 1" IRON PIPE FOUND (UNLESS OTHERWISE STATED)
- 1" DIA. IRON PIPE SET, 18" LONG
- MANHOLE
- UTILITY BOX
- UTILITY POLE W/ GUY WIRE
- CONCRETE
- ASPHALT

(A) LENGTH: 78.348'  
"I" ANGLE: 22°20'00"  
RADIUS: 201.00'  
CHORD: 77.85'  
BEARING: N33°42'00"E

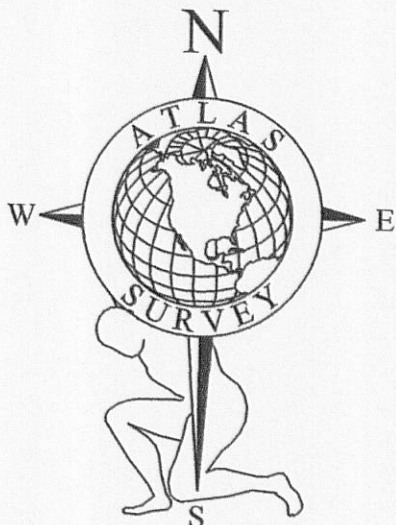

DIVISION STREET  
66' ROW

UNPLATTED LANDS

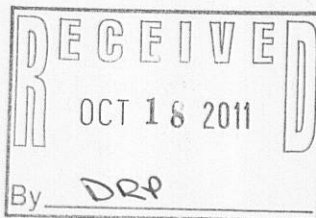

### SURVEYOR'S CERTIFICATE:

I HEREBY CERTIFY THAT I HAVE SURVEYED THE ABOVE DESCRIBED PROPERTY AND, IN MY PROFESSIONAL OPINION, THE ABOVE MAP IS A TRUE REPRESENTATION THEREOF AND SHOWS THE SIZE AND LOCATION OF THE PROPERTY, ITS EXTERIOR BOUNDARIES, THE LOCATION OF ALL VISIBLE STRUCTURES AND DIMENSIONS OF ALL PRINCIPAL BUILDINGS THEREON, BOUNDARY FENCES, APPARENT EASEMENTS, ROADWAYS AND VISIBLE ENCROACHMENTS, IF ANY.

THIS SURVEY IS MADE FOR THE USE OF THE PRESENT OWNERS OF THE PROPERTY, AND ALSO THOSE WHO PURCHASE, MORTGAGE, OR GUARANTEE THE TITLE THERETO WITHIN ONE (1) YEAR FROM DATE HEREOF.

