


**WALWORTH COUNTY
SURVEYING & MAPPING**

727 HENRY STREET
LAKE GENEVA, WISCONSIN
414-248-0505

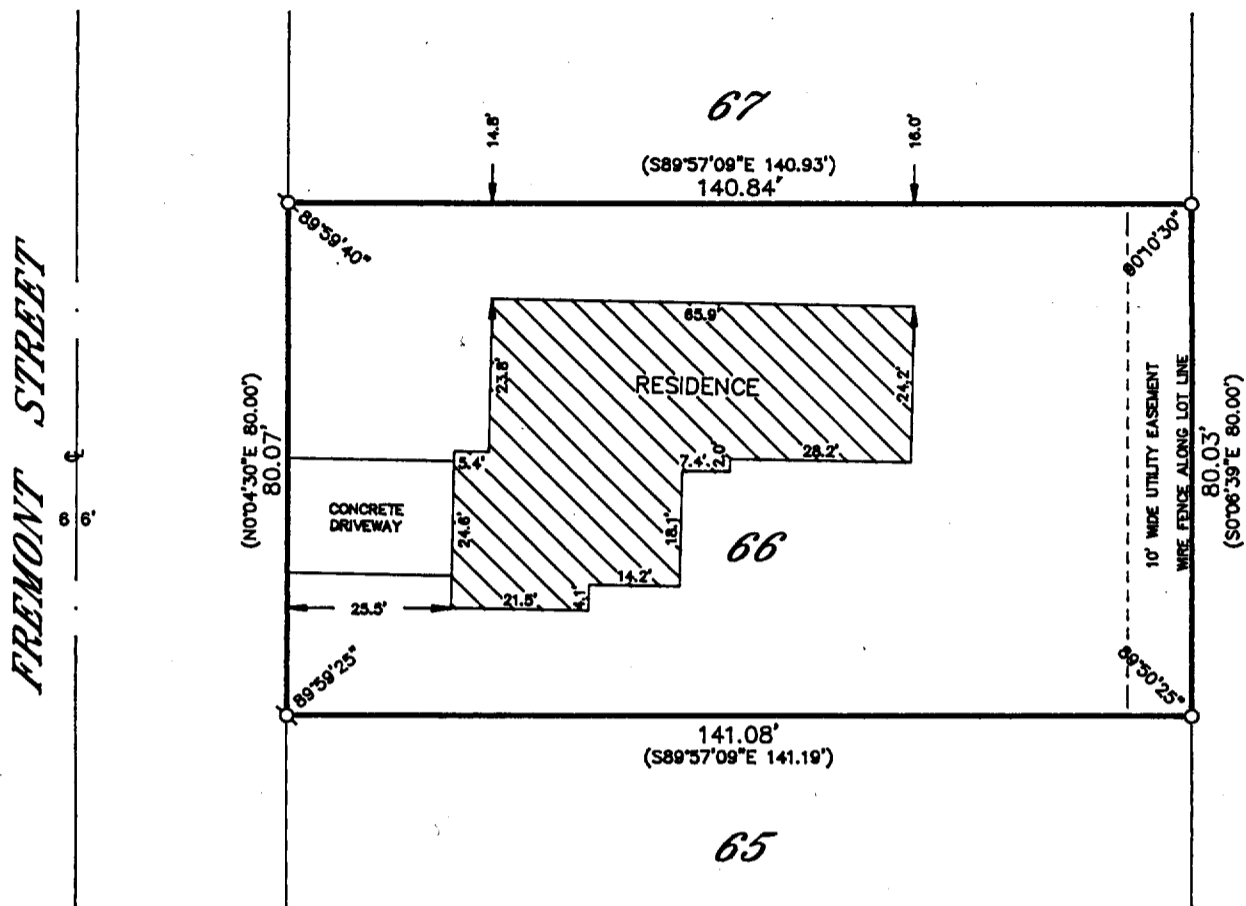


PLAT OF SURVEY OF

LOT 66 OF LYNNDALE SUBDIVISION ADDITION NO. TWO,
LOCATED IN THE VILLAGE OF EAST TROY, WALWORTH
COUNTY, WISCONSIN.

ORDERED BY: JEANNE BELAND
1836 FREMONT STREET
EAST TROY, WISCONSIN

WALWORTH COUNTY
RECEIVED
JAN 16 1992
dy

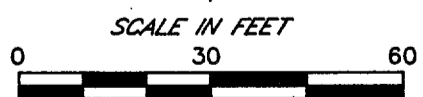

- LEGEND**
- IRON PIPE FOUND
 - ⊗—IRON ROD FOUND
 - CONCRETE MONUMENT FOUND
 - IRON PIPE PLACED
 - ()—RECORDED AS

I HEREBY CERTIFY THAT I HAVE SURVEYED THE ABOVE DESCRIBED PROPERTY AND THAT THE ABOVE MAP IS A TRUE REPRESENTATION THEREOF AND SHOWS THE SIZE AND LOCATION OF THE PROPERTY, ITS EXTERIOR BOUNDARIES, THE LOCATION OF ALL VISIBLE STRUCTURES AND DIMENSIONS OF ALL PRINCIPAL BUILDINGS THEREON, BOUNDARY FENCES, APPARENT EASEMENTS, ROADWAYS AND VISIBLE ENCROACHMENTS, IF ANY, TO THE BEST OF MY KNOWLEDGE AND BELIEF.

THIS SURVEY IS MADE FOR THE USE OF THE PRESENT OWNERS OF THE PROPERTY AND ALSO THOSE WHO PURCHASE, MORTGAGE OR GUARANTEE THE TITLE THERETO WITHIN ONE (1) YEAR FROM DATE HEREOF.

Robert M. Baerenwald
ROBERT M. BAERENWALD
WISCONSIN REGISTERED LAND SURVEYOR, S-1508

March 28, 1991
DATE JOB NO. 2857

NOTE: THIS IS NOT A CERTIFIED COPY UNLESS SEALED.

003-367

RLSB-5