
PLAT OF SURVEY

BEING ALL OF LOT 113 OF LAKE BLUFF, LOCATED IN THE SW 1/4 OF SEC. 17 (GOVERNMENT LOT 3), T.4N., R.18E., VILLAGE OF EAST TROY, WALWORTH COUNTY, WI.

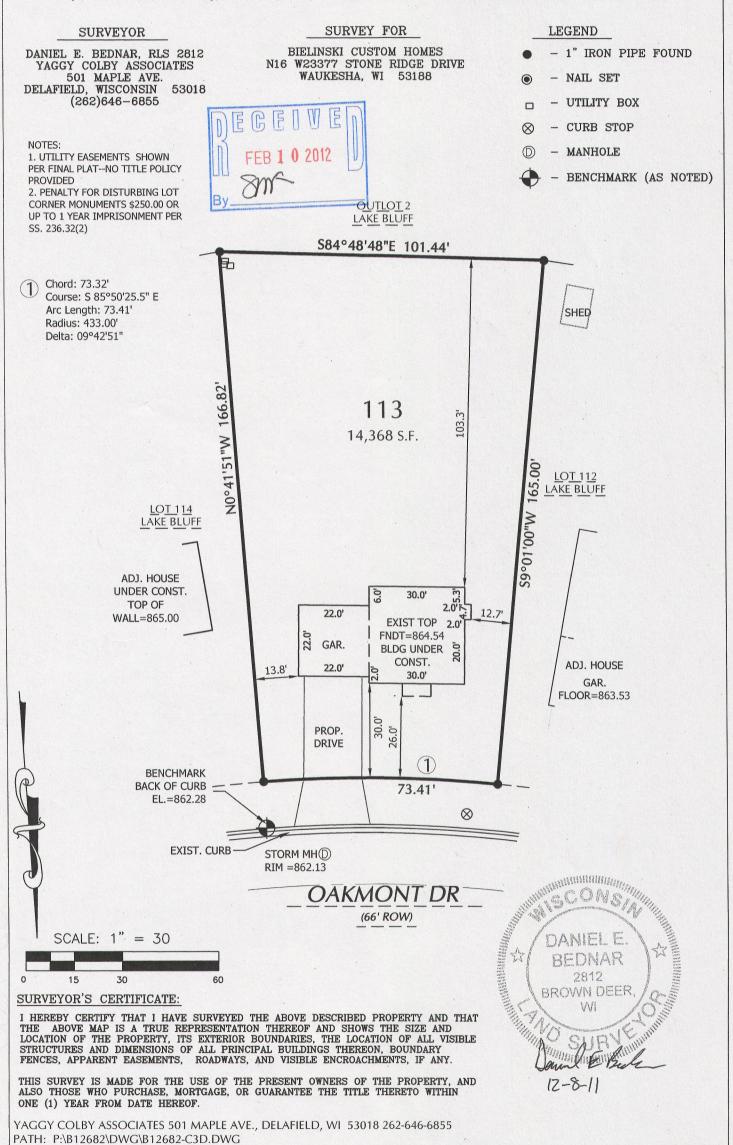

RB-113