


Plat of Survey
A parcel of land located in the SE 1/4 of Section 19, T4N, R18E, Village of East Troy, County of Walworth, State of Wisconsin, more particularly described as: Commencing at a point on the 1/8 Sec. Line between the E. and W. 1/2 of the SE 1/4 Sec. 19 T.4N. of R. 18E. 286 feet N. of a point where the N. side of the Milwaukee and Janesville Road crosses the 1/8 Sec. Line between the E. and W. 1/2 of the N.E. 1/4 Sec. 30 T.4N. of R.18E, thence E. parallel with Sec. Line 4 chs. and 2 lks. to the center of Street, thence N. along center of said Street 80 ft., thence W. parallel with Sec. Line of said 1/8 Sec. line, thence S. 80 ft. to place of beginning.

Surveyed for: Terry Collamore
Survey address: 2085 Beulah Ave.

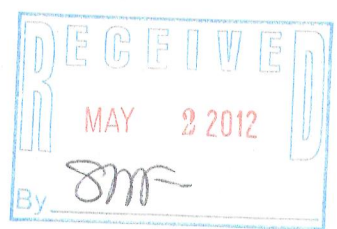

- FOUND 6" CONC. MON. W/BRASS CAP
- FOUND 1" IRON PIPE
- FOUND 1 1/2" IRON PIN
- SET 1" IRON PIPE
- () RECORDED AS DIMENSIONS

"I hereby certify that I have surveyed the above described property and that the above map is a true representation thereof and shows the size and location of the property, its exterior boundaries, the location of all visible structures and dimension of all principal buildings thereon, boundary fences, apparent easements, roadways and encroachments if any."

"This survey is made for the use of the present owners of the property, and also those who purchase, mortgage or guarantee the title thereto within one year from date hereof."

KETTLE MORaine SURVEYING INC.
575 W36245 Wilton Road
Eagle Wisconsin 53119
P.O. Box 357
(262) 594-3484
Terrance E. Pisarek R.L.S.



THIS IS NOT AN ORIGINAL SURVEY UNLESS THE SEAL IS RED.

3/22/12	TEP	TEP	12020
DATE	FIELD WORK BY	DRAWN BY	JOB NUMBER

RXUP-105

003-1001