

RLB 00127
003-1030

003-1030

DANIEL E. BEDNAR, RLS S-2812

SURVEY FOR:
BIELINSKI HOMES, INC
RE: JAGIELSKI
1830 MEADOW LANE, SUITE A
PEWAUKEE, WI 53072


— 1" IRON PIPE FOUND

☐ - UTILITY BOX

⑤ — MANHOLE

NOTES:

1. UTILITY EASEMENTS NOT SHOWN--NO TITLE POLICY PROVIDED
2. THIS SURVEY IS SUBJECT TO ALL RESTRICTIONS AND NOTES SHOWN ON THE FINAL PLAT OF LAKE BLUFF RECORDED AT WALWORTH COUNTY REGISTER OF DEEDS OFFICE.
3. PENALTY FOR DISTURBING LOT CORNER MONUMENTS \$250.00 OR UP TO 1 YEAR IMPRISONMENT PER S.S. 236.32(2)

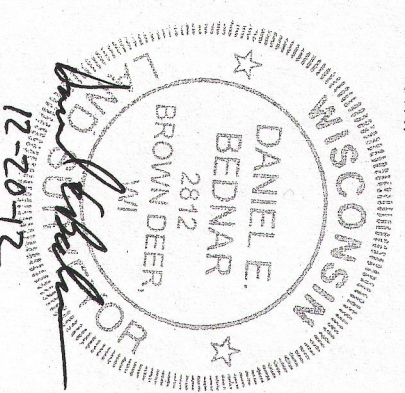

YAGGY COLBY ASSOCIATES 501 MAPLE AVE., DELAFIELD, WI 53018 262-646-6855
PATH: P:\B12682\DWG\B12682-HSO-C3D.DWG