

PLAT OF SURVEY


BEING ALL OF LOT 111 OF LAKE BLUFF, LOCATED IN THE SW 1/4 OF SEC. 17 (GOVT LOT 3), T.4N., R.18E., VILLAGE OF EAST TROY, WALWORTH COUNTY, WI.

SURVEYOR:  
DANIEL E. BEDNAR, RLS S-2812  
YAGGY COLBY ASSOCIATES  
501 MAPLE AVE  
DELAFIELD, WI 53018  
(262) 646-6855

SURVEY FOR:  
BIELINSKI HOMES, INC  
1830 MEADOW LANE, SUITE A  
PEWAUKEE, WI 53072

NOTES:  
1. UTILITY EASEMENTS SHOWN PER FINAL PLAT--NO TITLE POLICY PROVIDED  
2. THIS SURVEY IS SUBJECT TO ALL RESTRICTIONS AND NOTES SHOWN ON THE FINAL PLAT OF LAKE BLUFF RECORDED AT WAUKESHA COUNTY REGISTER OF DEEDS OFFICE.  
3. PENALTY FOR DISTURBING LOT CORNER MONUMENTS \$250.00 OR UP TO 1 YEAR IMPRISONMENT PER SS. 236.32(2)

- LEGEND
- 1" IRON PIPE FOUND
  - 2" IRON PIPE FOUND
  - UTILITY BOX
  - MAPLEHEART
  - STORM/SANITARY MANHOLE
  - x XXX.XX - EX. GROUND ELEV. AS OF DATE OF SURVEY
  - BENCHMARK (AS NOTED)
  - (XXX.X) - ADJ. YARD GRADE PER MASTER GRADING PLAN
  - x ~~XXX.XX~~ - TOP OF STAKE ELEV.

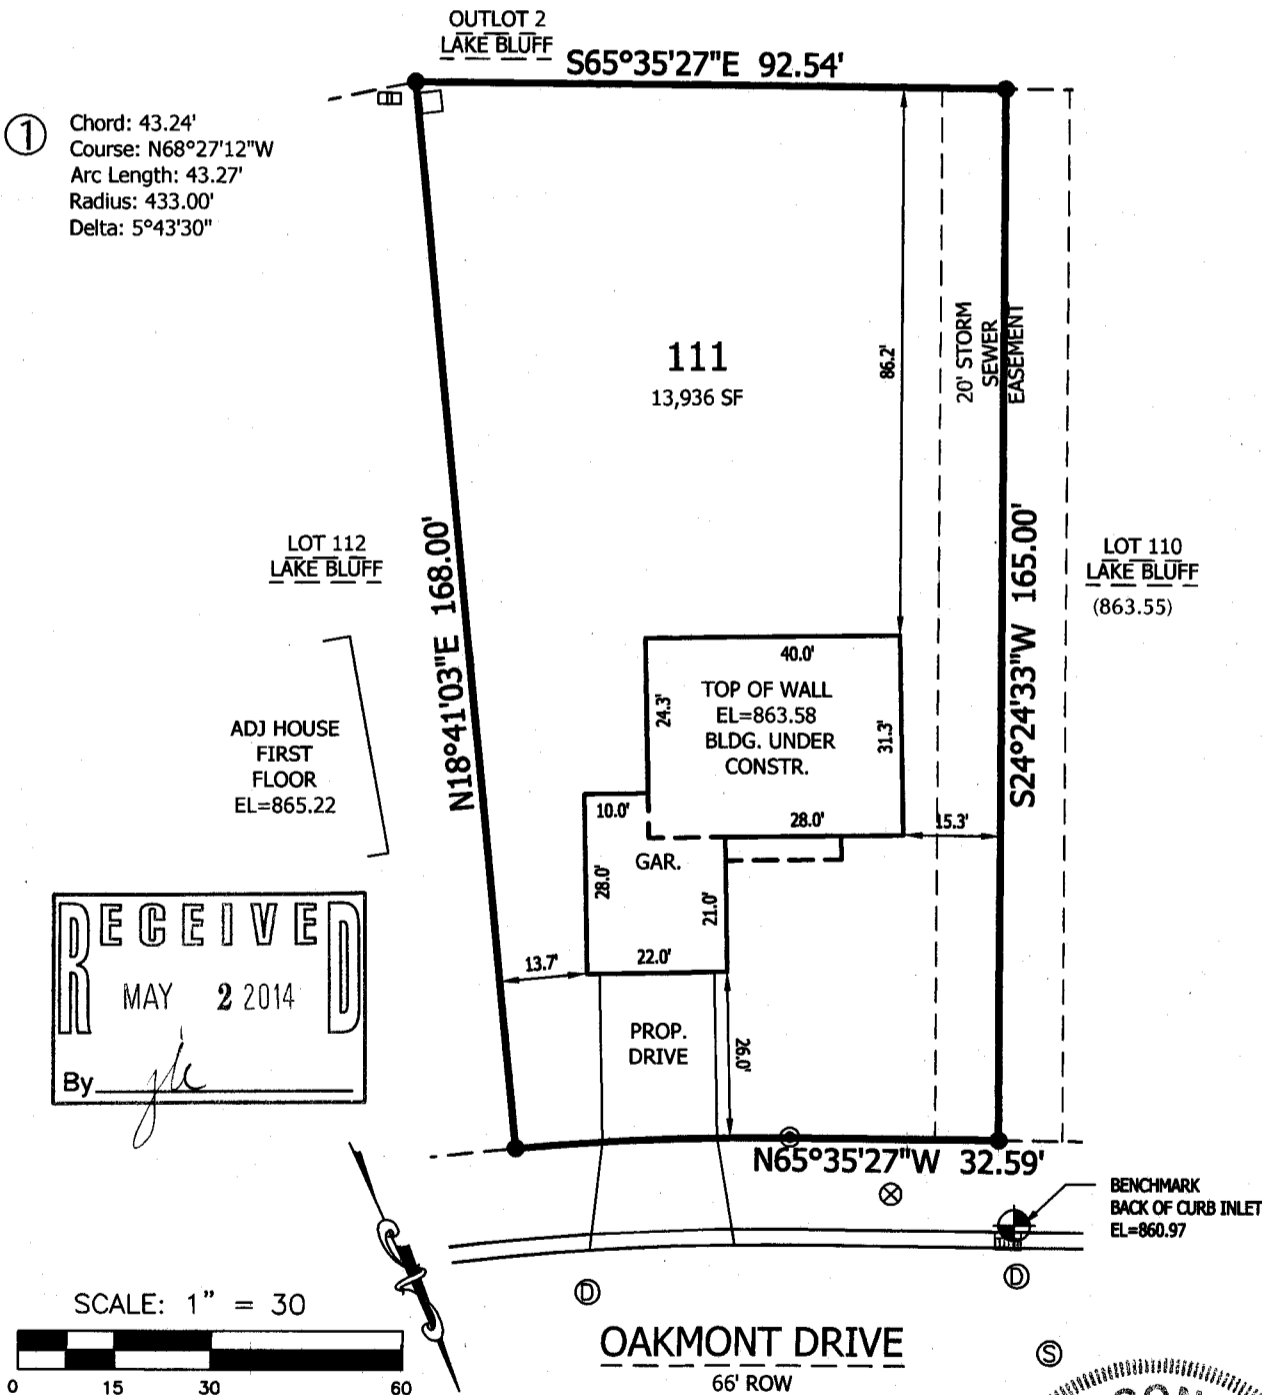


SURVEYOR'S CERTIFICATE:

I HEREBY CERTIFY THAT I HAVE SURVEYED THE ABOVE DESCRIBED PROPERTY AND THAT THE ABOVE MAP IS A TRUE REPRESENTATION THEREOF AND SHOWS THE SIZE AND LOCATION OF THE PROPERTY, ITS EXTERIOR BOUNDARIES, THE LOCATION OF ALL VISIBLE STRUCTURES AND DIMENSIONS OF ALL PRINCIPAL BUILDINGS THEREON, BOUNDARY FENCES, APPARENT EASEMENTS, ROADWAYS, AND VISIBLE ENCROACHMENTS, IF ANY.

THIS SURVEY IS MADE FOR THE USE OF THE PRESENT OWNERS OF THE PROPERTY, AND ALSO THOSE WHO PURCHASE, MORTGAGE, OR GUARANTEE THE TITLE THERETO WITHIN ONE (1) YEAR FROM DATE HEREOF.

YAGGY COLBY ASSOCIATES 501 MAPLE AVE., DELAFIELD, WI 53018 262-646-6855  
PATH: P:\B12682\DWG\111 POS.DWG

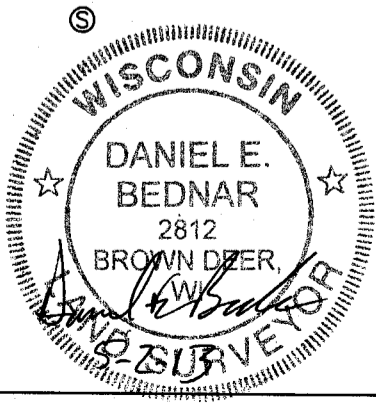

RLB-111

003-1041