


BEING ALL OF LOT 58 OF LAKE BLUFF, LOCATED IN THE SW 1/4 OF SEC. 17 (GOVT LOT 3), T.4N., R.18E., VILLAGE OF EAST TROY, WALWORTH COUNTY, WI.

**SURVEY FOR:
BIELINSKI HOMES, INC
RE: GRIMM
1830 MEADOW LANE, SUITE A
PEWAUKEE, WI 53072**

- - 1" IRON PIPE FOUND
- - UTILITY BOX
- (XXX.X) - ADJ. YARD GRADE PER MASTER GRADING PLAN
- ⊗ - INLET

1. UTILITY EASEMENTS SHOWN PER
FINAL PLAT--NO TITLE POLICY PROVIDED
2. THIS SURVEY IS SUBJECT TO ALL
RESTRICTIONS AND NOTES SHOWN ON
THE FINAL PLAT OF LAKE BLUFF
RECORDED AT WALWORTH COUNTY
REGISTER OF DEEDS OFFICE.
3. PENALTY FOR DISTURBING LOT
CORNER MONUMENTS \$250.00 OR UP TO
1 YEAR IMPRISONMENT PER SS. 236.32(2)

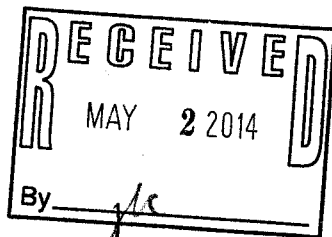


Response Category	Percentage
Never	10
Rarely	10
Sometimes	10
Often	30
Always	10

I HEREBY CERTIFY THAT I HAVE SURVEYED THE ABOVE DESCRIBED PROPERTY AND THAT THE ABOVE MAP IS A TRUE REPRESENTATION THEREOF AND SHOWS THE SIZE AND LOCATION OF THE PROPERTY, ITS EXTERIOR BOUNDARIES, THE LOCATION OF ALL VISIBLE STRUCTURES AND DIMENSIONS OF ALL PRINCIPAL BUILDINGS THEREON, BOUNDARY FENCES, APPARENT EASEMENTS, ROADWAYS, AND VISIBLE ENCROACHMENTS, IF ANY.

THIS SURVEY IS MADE FOR THE USE OF THE PRESENT OWNERS OF THE PROPERTY, AND ALSO THOSE WHO PURCHASE, MORTGAGE, OR GUARANTEE THE TITLE THERETO WITHIN ONE (1) YEAR FROM DATE HEREOF.

YAGGY COLBY ASSOCIATES 501 MAPLE AVE., DELAFIELD, WI 53018 262-646-6855
PATH: P:\B12682\DWG\058 POS.DWG

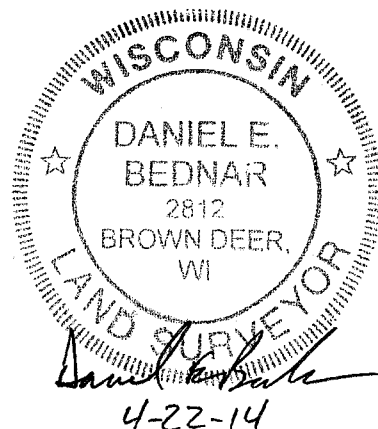

RLB-58

003-1043