



PLAT OF SURVEY

LOT 24, STERLING OAKS, being a Subdivision of part of the Southeast 1/4 of the Northwest 1/4 and part of the Northwest 1/4 and Southwest 1/4 of the Northeast 1/4 of Section 20, Township 4 North, Range 18 East, in the Village of East Troy, Walworth County, Wisconsin.

Surveyed for: Bielinski Bros. Builders/Gerald Nickels and Jacqueline

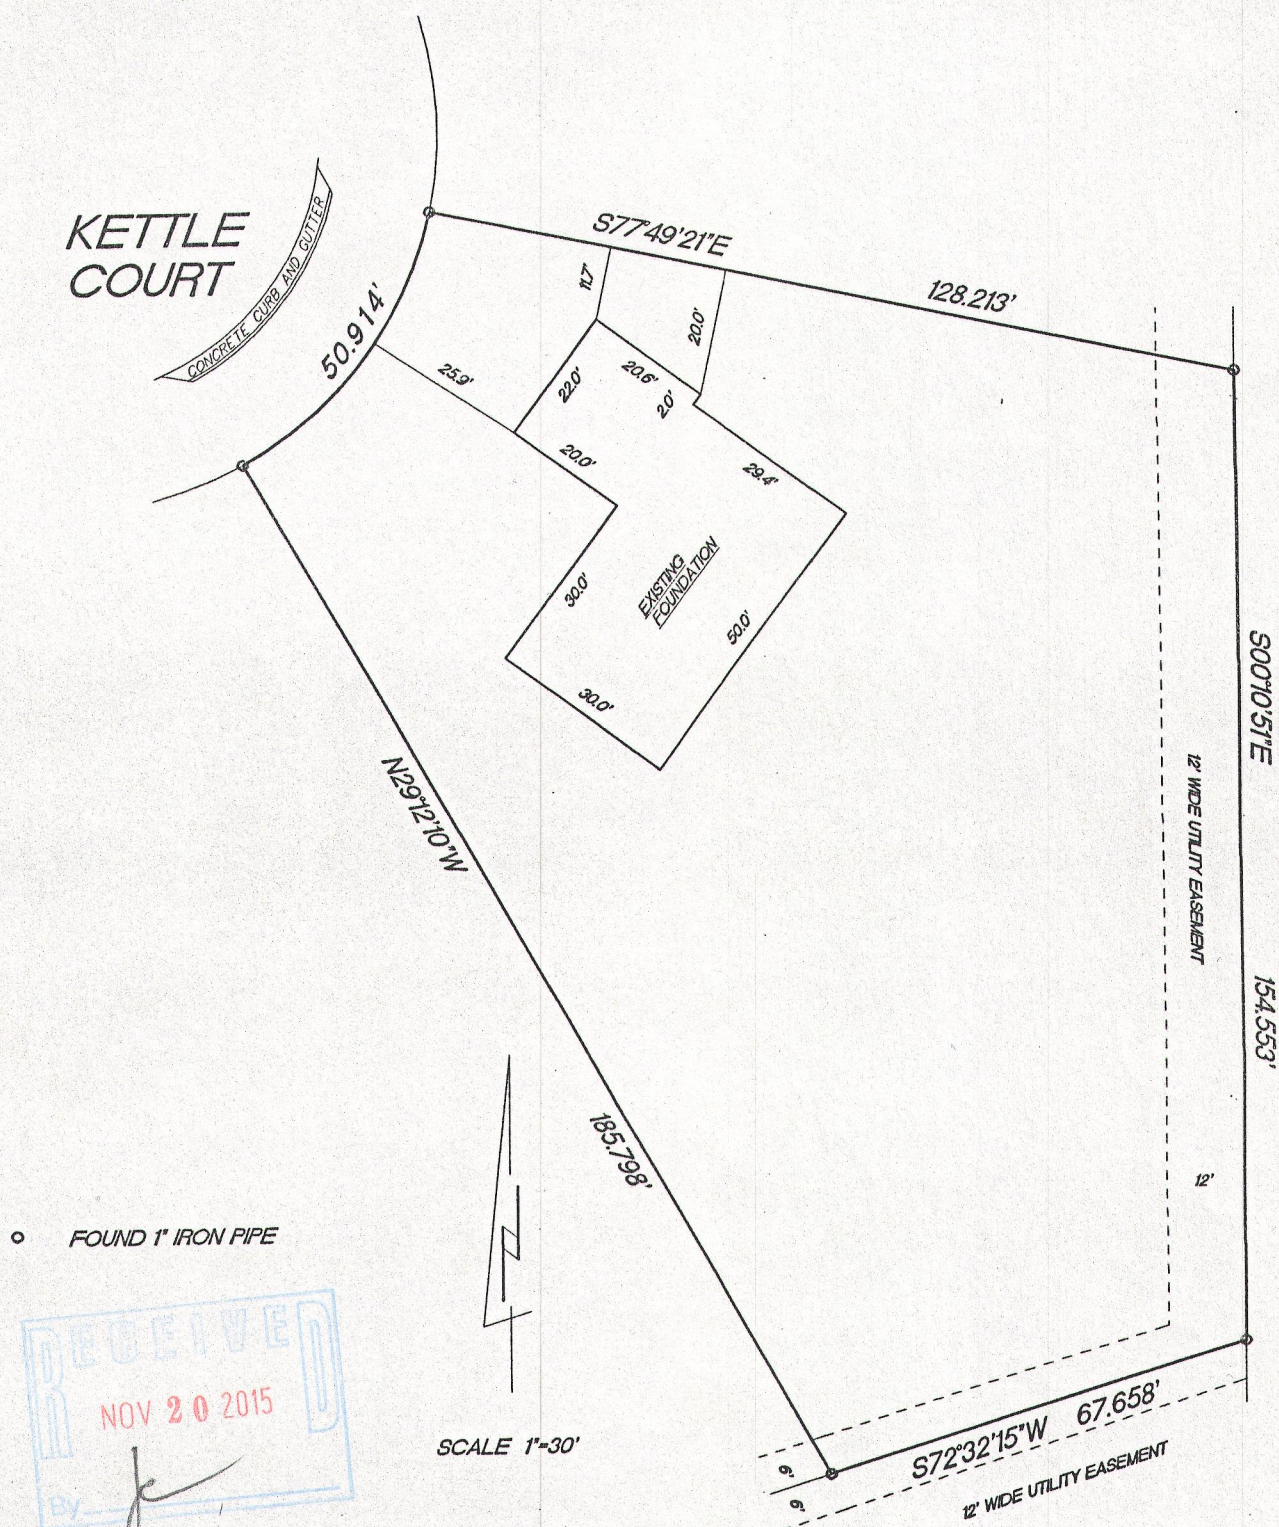

○ FOUND 1" IRON PIPE

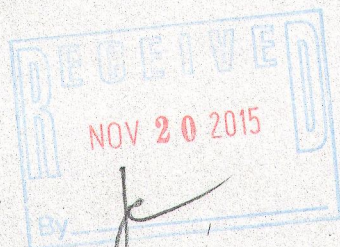

SCALE 1"=30'


RADIUS	LENGTH	CHORD	BEARING	DELTA
60.000'	50.914'	49.401'	N36°29'14.5"E	48°37'11"

"I hereby certify that I have surveyed the above described property and that the above map is a true representation thereof and shows the size and location of the property, its exterior boundaries, the location of all visible structures and dimension of all principal buildings thereon, boundary fences, apparent easements, roadways and encroachments if any."

"This survey is made for the use of the present owners of the property, and also those who purchase, mortgage or guarantee the title thereto within one year from date hereof."



W356 S9050 Godfrey Lane  
P.O. Box 357  
Eagle WI. 53119

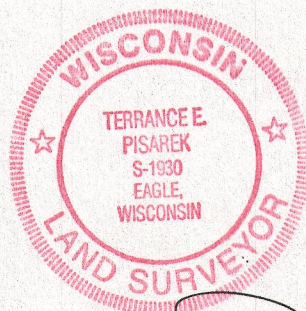

(414) 594-3484  
fax (414) 594-5904

THIS IS NOT AN ORIGINAL SURVEY UNLESS THE SEAL IS RED.

REV. 6/25/99  
3/15/99  
DATE  
TEP/DW  
FIELD WORK BY

TEP  
DRAWN BY  
99059  
JOB NUMBER

R870-24 003-1066