

PLAT OF SURVEY

FOUNDATION ASBUILT

LOT 13 OF LAKE BLUFF SUBDIVISION, BEING PART OF CERTIFIED SURVEY MAP No. 2265, LOCATED IN THE SE $\frac{1}{4}$, NW $\frac{1}{4}$, & SW $\frac{1}{4}$, OF THE SW $\frac{1}{4}$ OF SECTION 17, (GOVERNMENT LOT 3) TOWNSHIP 4 NORTH, RANGE 18 EAST, VILLAGE OF EAST TROY, WALWORTH COUNTY, WISCONSIN.



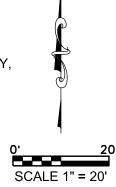

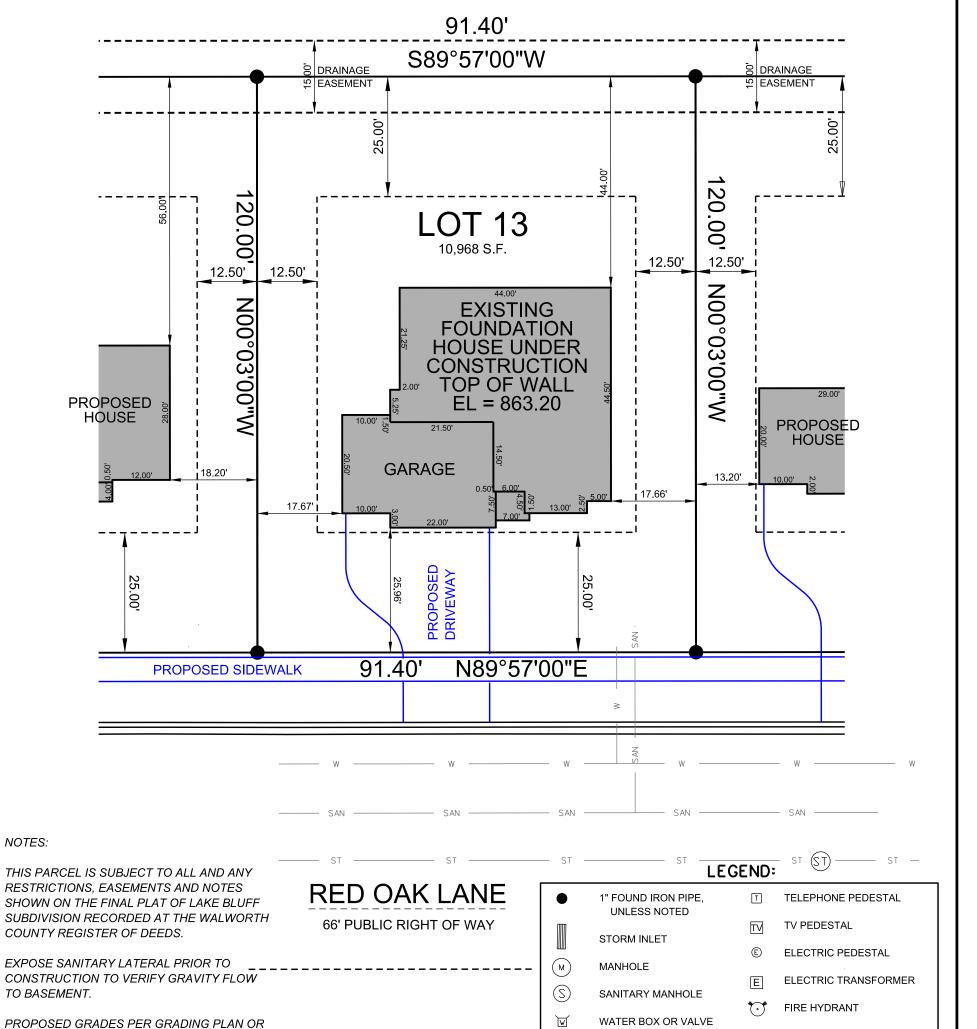

(262) 378-5097

HEIGHTS PRIOR TO EXCAVATION.

ADJUSTED BY BUILDER. CONTRACTOR TO

VERIFY ALL PROPOSED GRADES AND WALL

SURVEY MADE FOR: BIELINSKI HOMES, INC. 1830 MEADOW LANE PEWAUKEE, WI 53072

DATE ITEM
06/15/2021 PRELIM SURVEY
06/25/2021 PERMIT SURVEY
09/28/2021 FOUND. ASBUILT

THIS SURVEY IS MADE FOR THE USE OF THE PRESENT OWNERS OF THE PROPERTY, AND ALSO THOSE WHO PURCHASE, MORTGAGE OR GUARANTEE TITLE TO WITHIN ONE (1) YEAR FROM DATE HERETO.

I, MICHAEL A. GREESON P.L.S. #2770, HEREBY CERTIFY THAT THIS SURVEY WAS MADE IN ACCORDANCE WITH THE MINIMUM STANDARDS FOR PROPERTY SURVEYS (CHAPTER A-E 7) FOR THE STATE OF WISCONSIN AND HAS BEEN PREPARED UNDER MY DIRECTION AND CONTROL AND IS CORRECT TO THE BEST OF MY KNOWLEDGE AND BELIEF.

SPOT ELEVATION

WATER LATERAL

SANITRAY LATERAL