


# PLAT OF SURVEY


CONTINUING AT A POINT IN THE NORTH LINE OF LOT 3, BLOCK 11, VILLAGE OF EAST TROY,  
46 FEET WEST OF THE NE CORNER OF SAID LOT 3, RUN THENCE SOUTH PARALLEL WITH THE  
EAST LINE OF SAID LOT TO THE SOUTH LINE OF SAID LOT, THENCE EAST ALONG THE SOUTH LINE  
OF SAID LOT 46 FEET TO THE SE CORNER OF SAID LOT THENCE NORTH ALONG THE EAST LINE  
OF SAID LOT TO THE NORTHEAST CORNER OF SAID LOT, THENCE WEST ALONG THE NORTH LINE  
OF SAID LOT 46 FEET TO THE POINT OF BEGINNING.

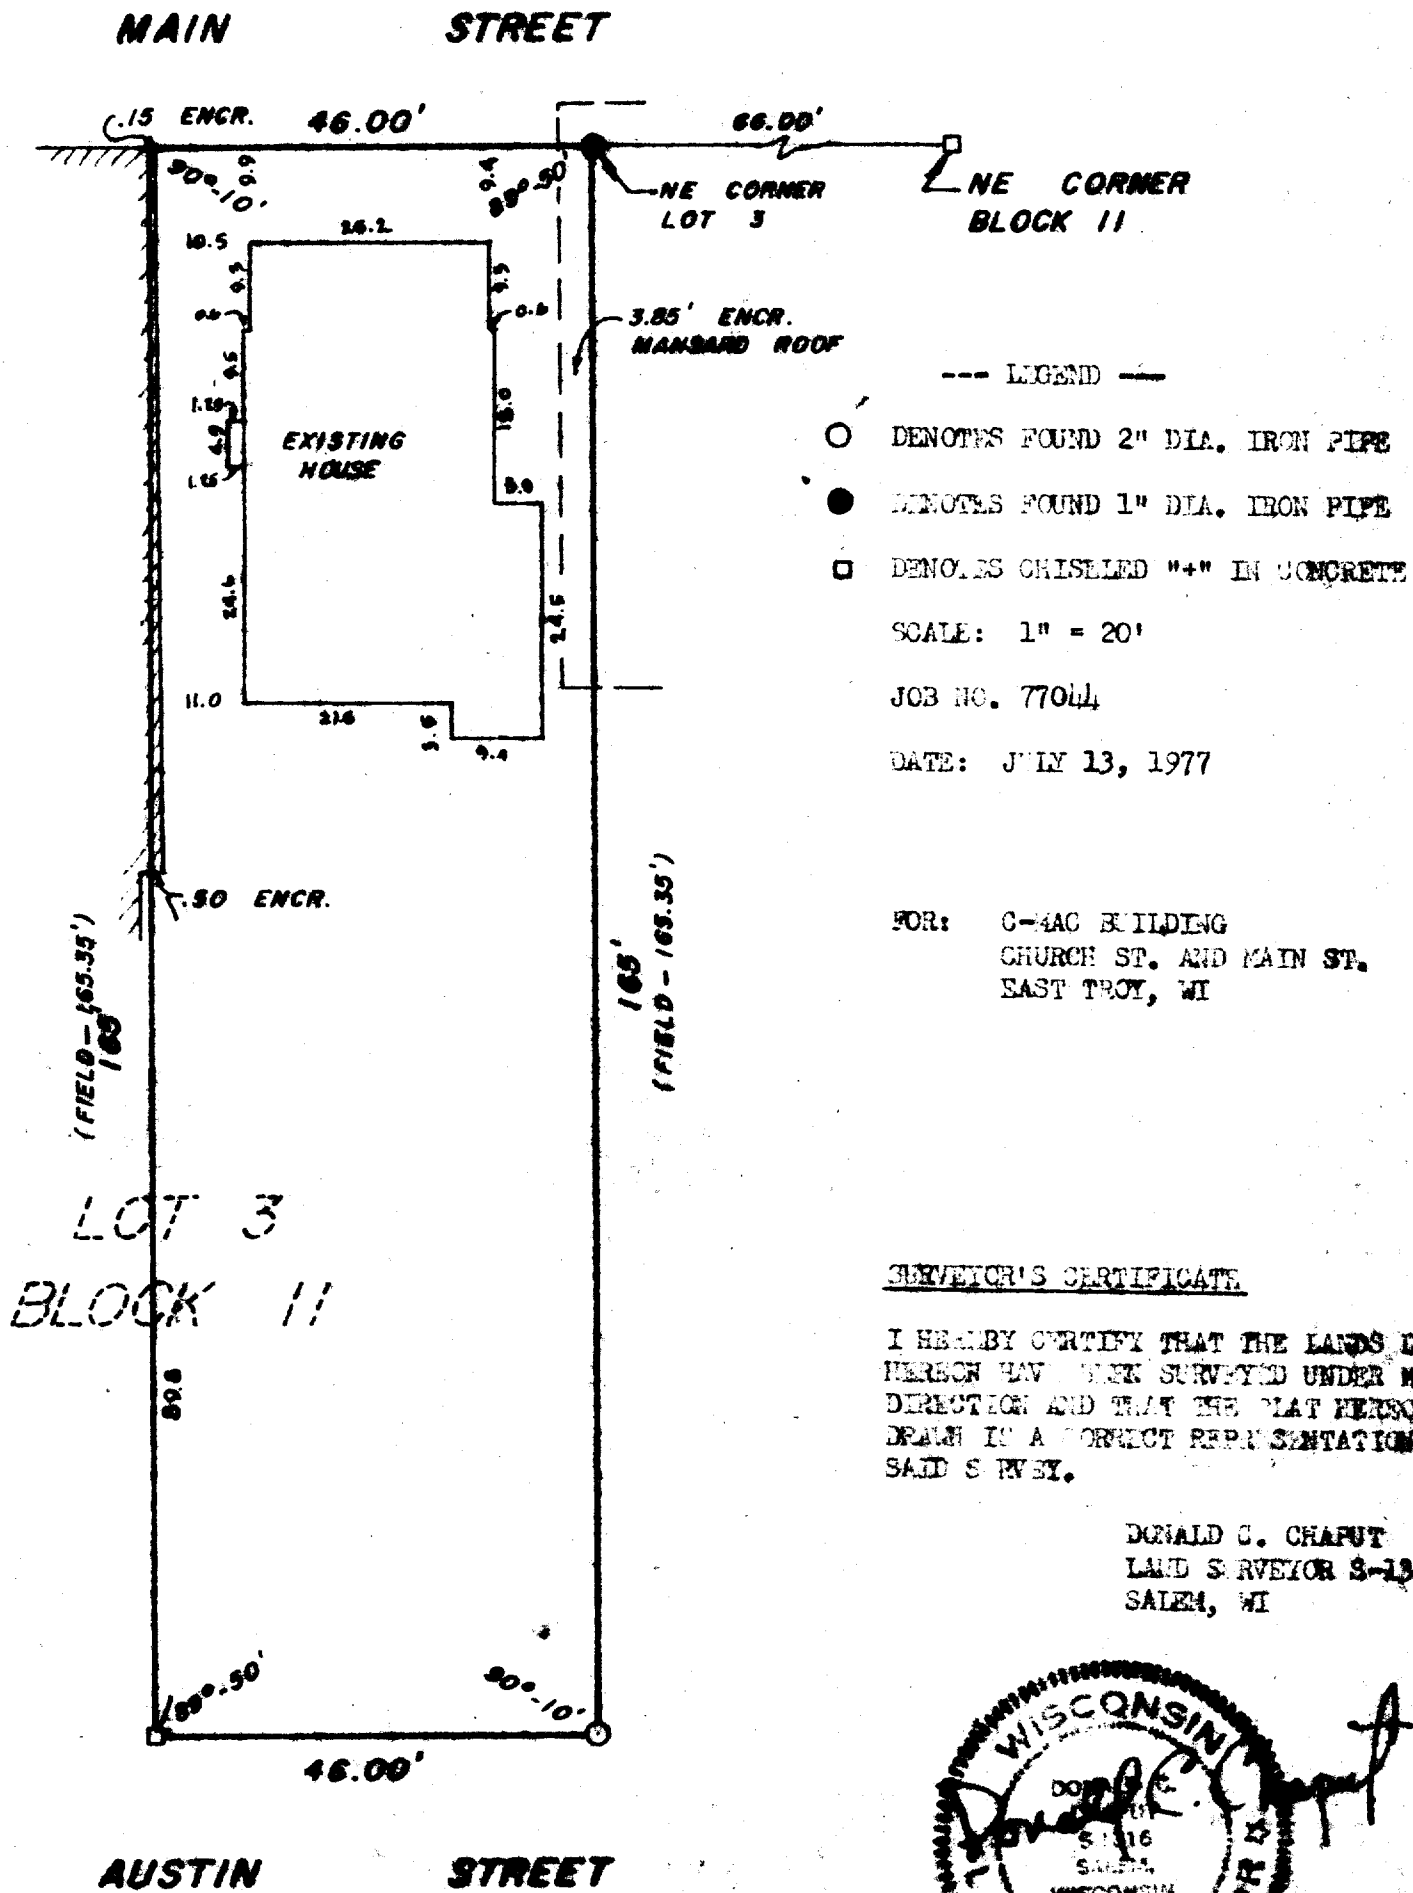

## SEVENOR'S CERTIFICATE

I HEREBY CERTIFY THAT THE LANDS DEPICTED  
HEREON HAVE BEEN SURVEYED UNDER MY  
DIRECTION AND THAT THE PLAT HEREON  
DRAWN IS A CORRECT REPRESENTATION OF  
SAID SURVEY.

DONALD C. CHAPUT  
LAND SURVEYOR 3-1316  
SALEM, WI

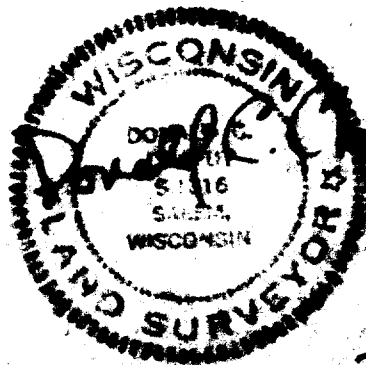

OP-107

3-163