


BUILDING STAKEOUT

BEARINGS AS RECORDED

LEGEND

- FOUND IRON PIPE
- HYDRANT
- ✕ BUILDING OFFSETS 10' (Elevs. TAKEN AT TOP OF HUB)

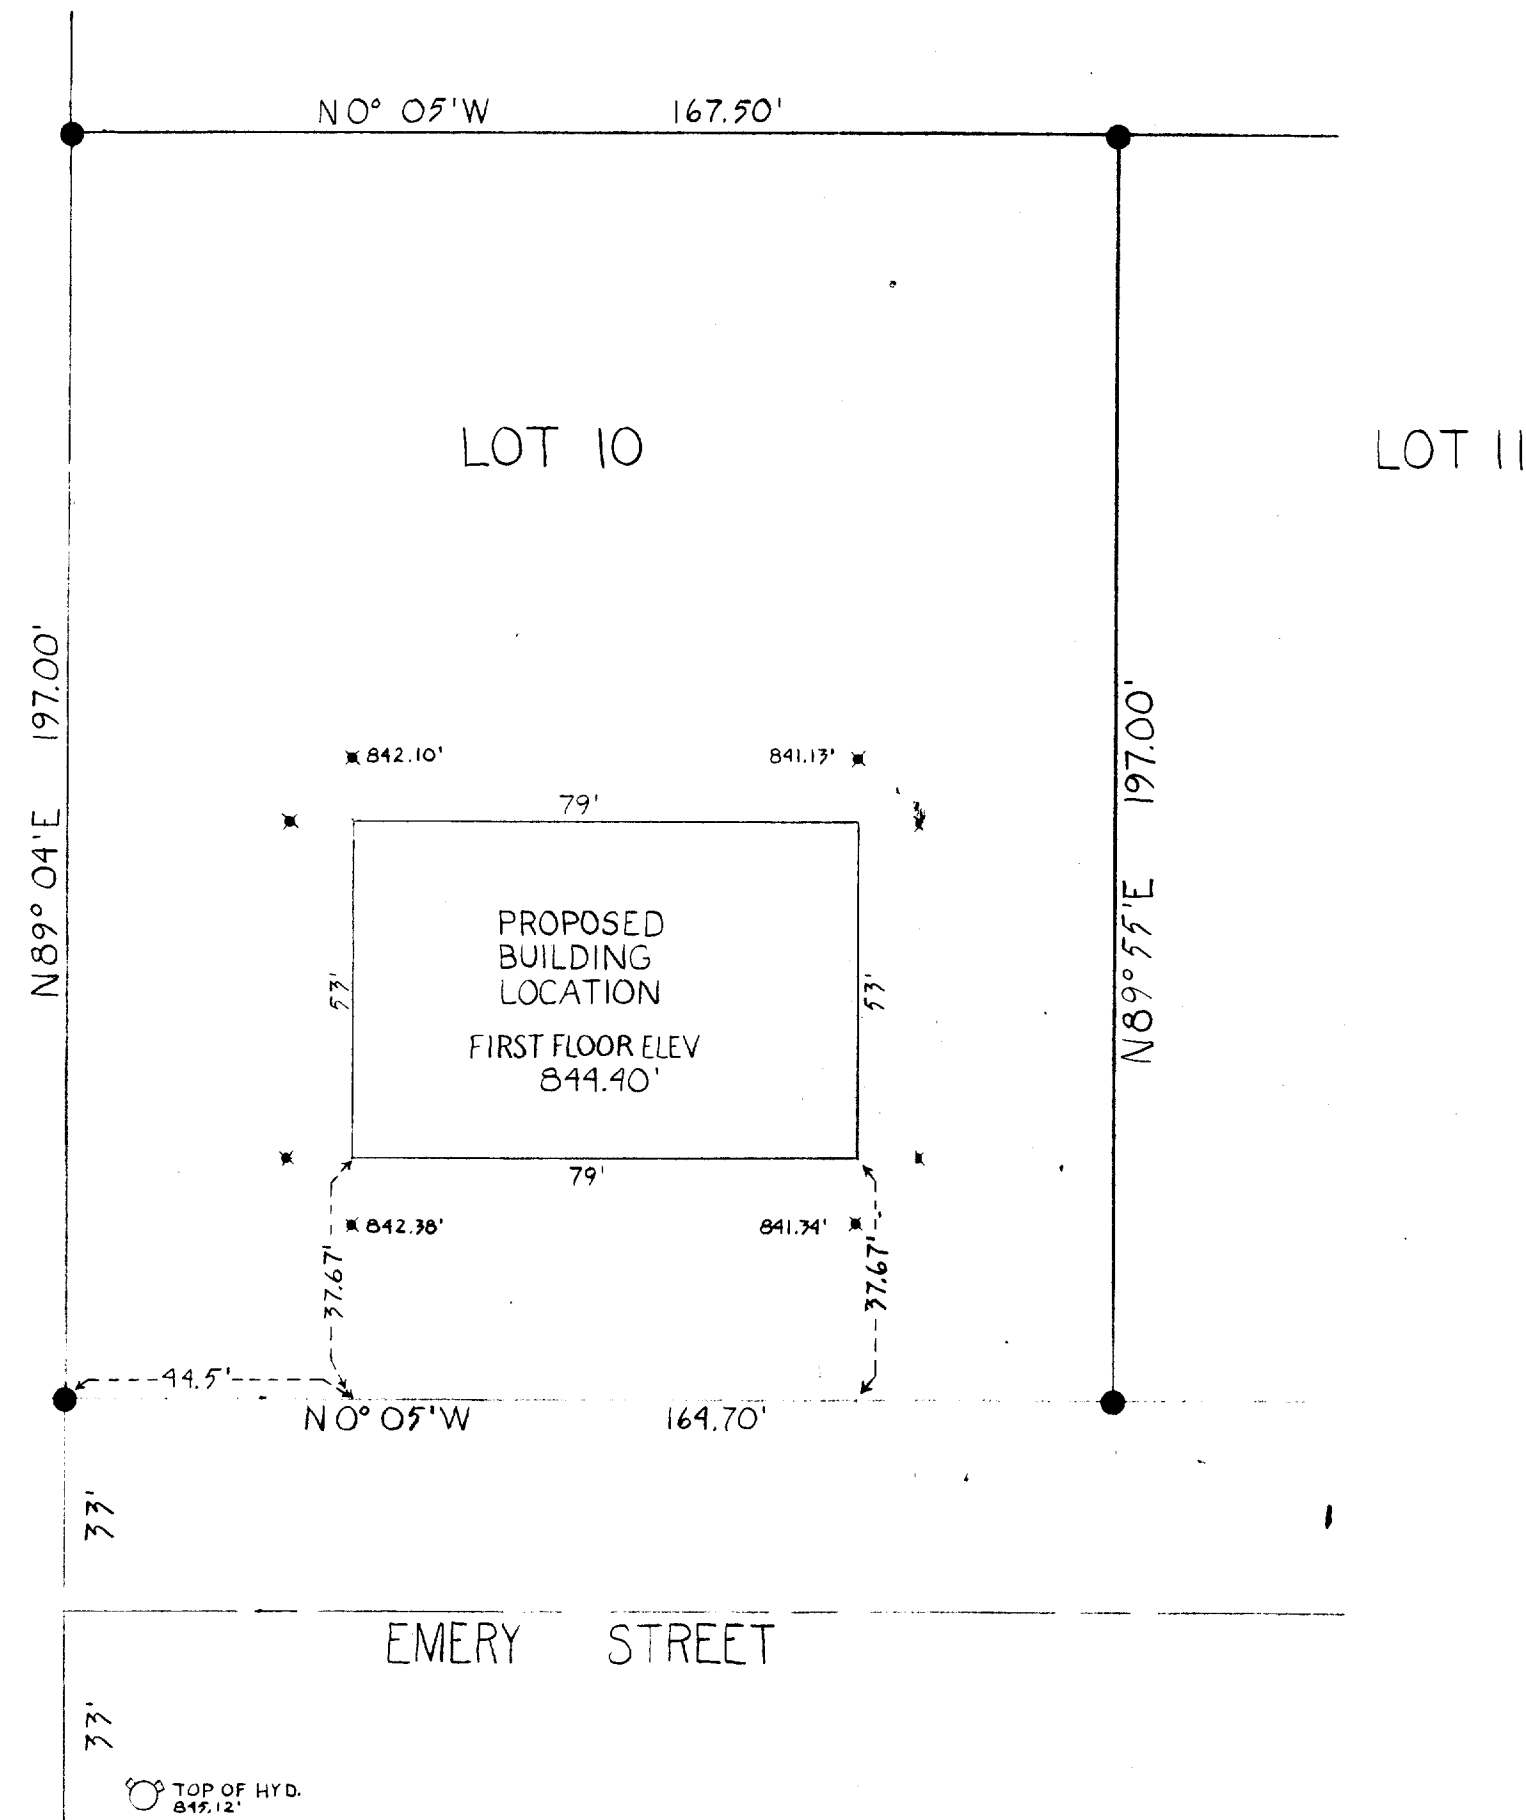


LOCATED IN LOT 10 OF TROYJENS APARTMENTS VILLAGE OF EAST TROY, WALWORTH COUNTY, WIS.

Surveyors Certificate

I, WILLIAM A. SHEARMAN REGISTERED LAND SURVEYOR DO HEREBY CERTIFY THAT THE PROPOSED BUILDING LOCATION HEREON IS A CORRECT REPRESENTATION STAKED UNDER MY DIRECTION AND TO THE BEST OF MY KNOWLEDGE AND BELIEF.

William A. Shearman
WILLIAM A. SHEARMAN 5-1378

JENSEN & JOHNSON
ENGINEERS AND SURVEYORS
PO BOX 290, ELKHORN, WISCONSIN
414-723-3204
A Division of
Donohue & Associates, Inc.

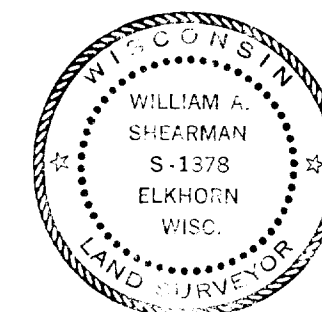

Date 4-7-78	Scale 1" = 30'
Drawn By D.J.H.	Surveyed For JOHNSON REALTY
Checked By D.J.C.	Project No. 1658.286