


Plat of Survey

Known as 1867 Thomas Drive, in the Village of East Troy, Wisconsin
 Lot 51 in LYNDAL, being a Subdivision of a part of the SE 1/4, NW 1/4 and the SW 1/4 of
 the NW 1/4 of Section 20, T 4 N, R 18 E, in the Village of East Troy, Walworth County,
 Wisconsin.

APRIL 4, 1979

DONALD F O'CONNELL

SURVEY NO. 138662-M

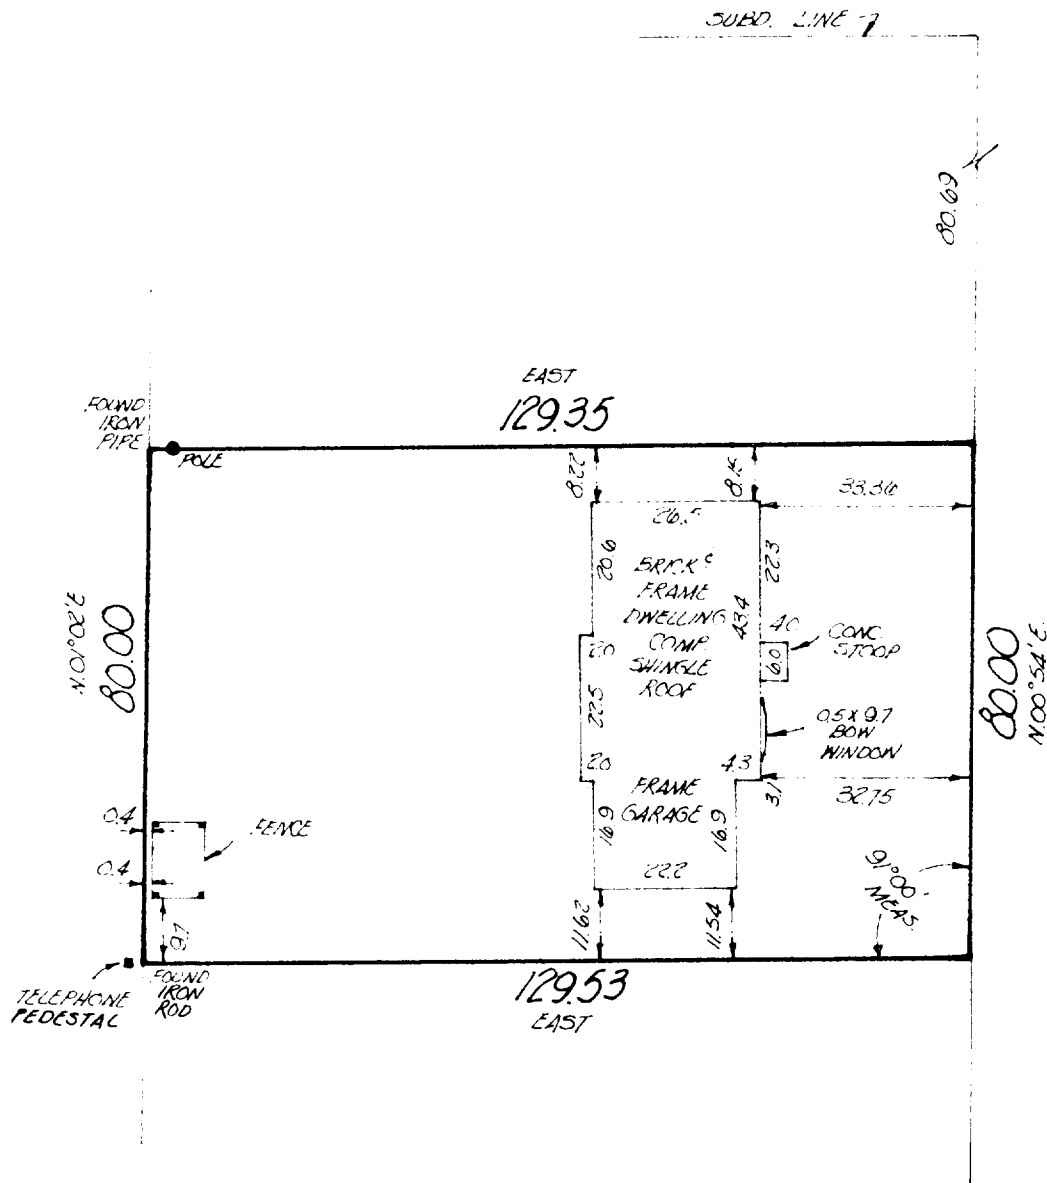

SCALE 1"=50'

I Certify that I have surveyed the above described property (Property), and the above map is a true representation thereof and shows the size and location of the Property, its exterior boundaries, the location and dimensions of all visible structures thereon, boundary fences, apparent easements and roadways and visible encroachments, if any.

This survey is made for the exclusive use of the present owners of the Property, and also those who purchase, mortgage, or guarantee the title thereto, within one (1) year from date hereof.

Kenneth E. Berke
 SURVEYOR



3-210



national survey & engineering

3470 north 127th street • p.o. box 444 • brookfield, wisconsin, 53005 • phone 414 / 781-1000