




Date September 19, 1983

PLAT OF SURVEY

Job No. Z-19-29606

LOT 2 - TROYJENS SUBDIVISION
being a part of the Southwest 1/4 of Section 19, Town 4 North, Range 18 East, Village of East Troy, Walworth County, Wisconsin.

Located at 1994 Townline Road

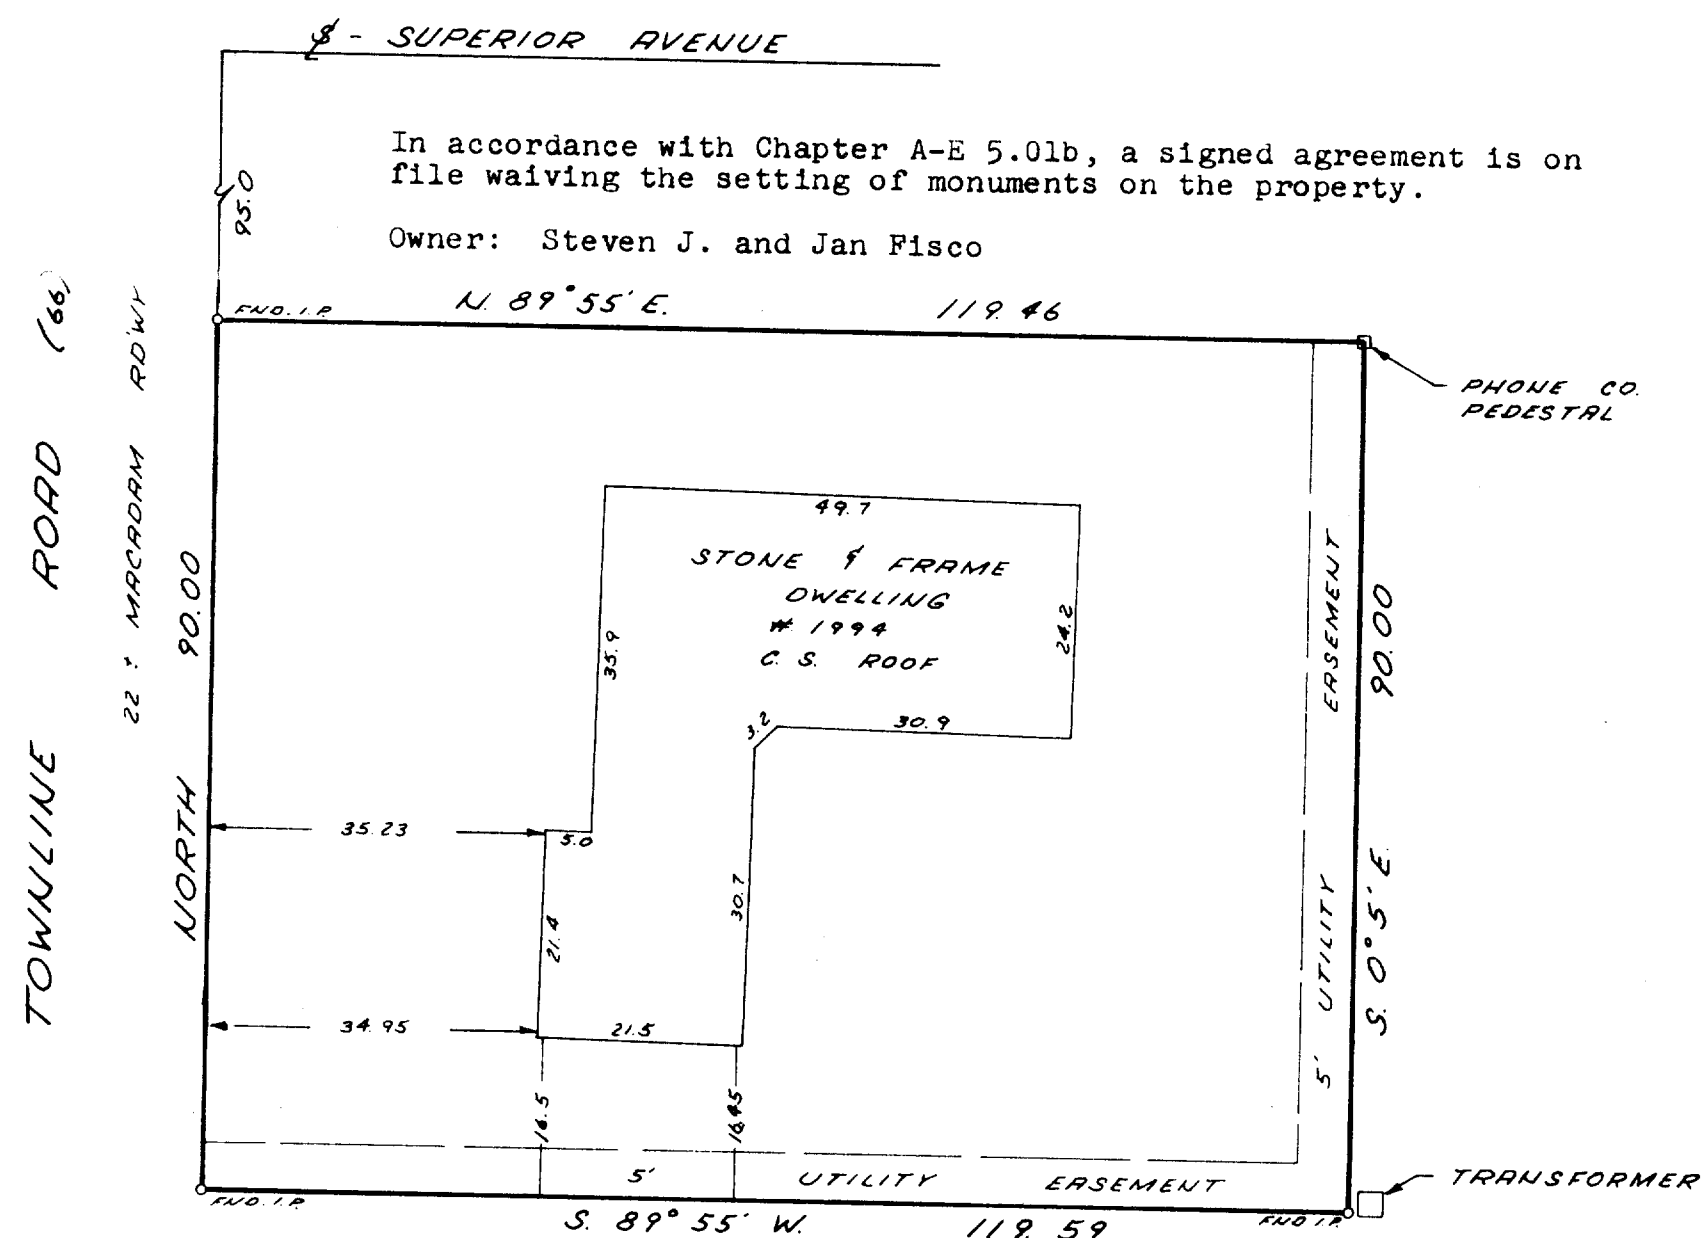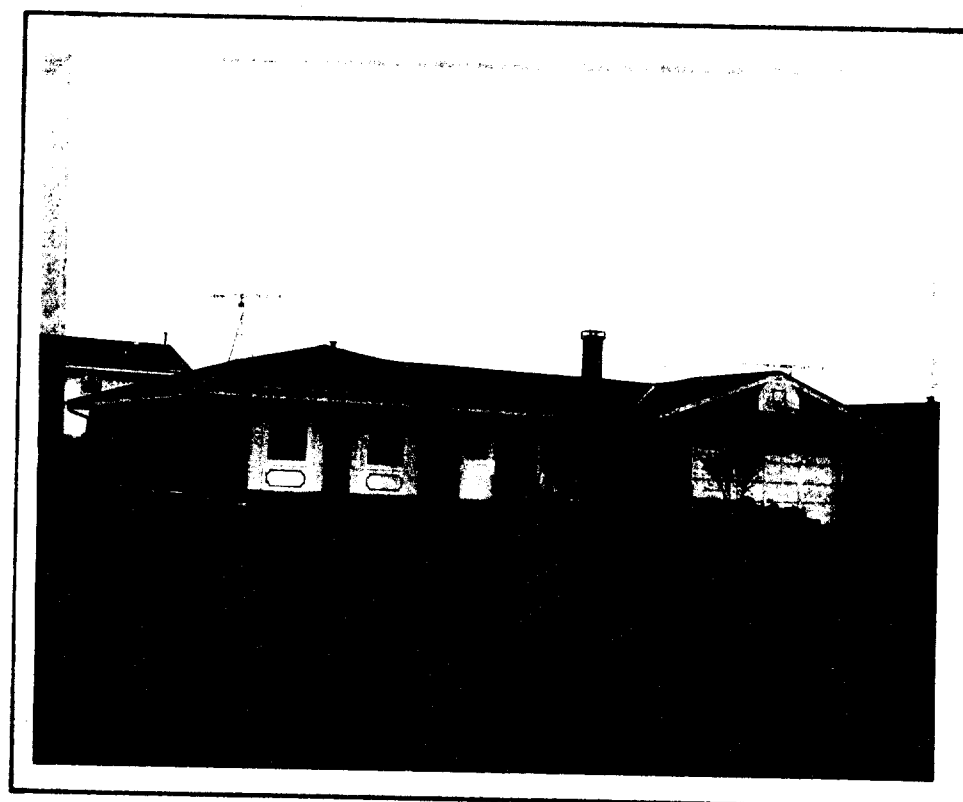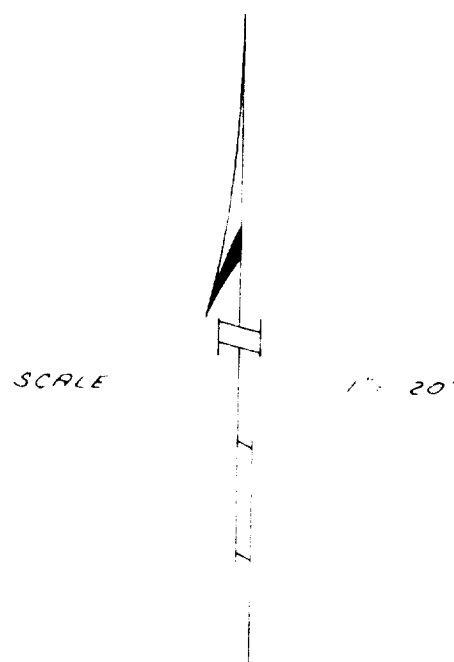

8522 West Lisbon Avenue
Milwaukee, Wisconsin 53222

SURVEYED FOR

St. Francis Savings and Loan Assn.
3545 S. Kinnickinnic Avenue
St. Francis, WI 53207


Surveyed by
RICHARD J. LAMMI

PHONE
461-3730

I have surveyed the above described property, and the above map is a true representation thereof and shows the size and location of the property, its exterior boundaries, the location and dimensions of all visible structures thereon, fences, apparent easements, roadways and visible encroachments.

This survey is made for the exclusive use of the present owners of the property, also those who purchase, mortgage or guarantee the title thereto, within one year from date hereof.

Richard J. Lammi D.L.
REGISTERED LAND SURVEYOR NO. 5-777 - STATE OF WISCONSIN

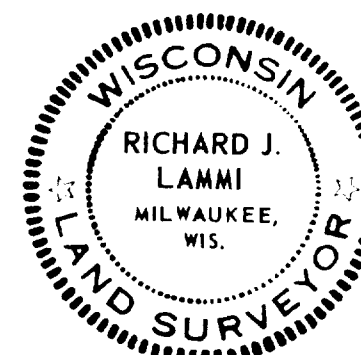

3-245