
RONALD H. ZIMMERMAN REGISTERED LAND SURVEYOR

PLAT OF SURVEY

FOR

WAUWATOSA MORTGAGE CORP.

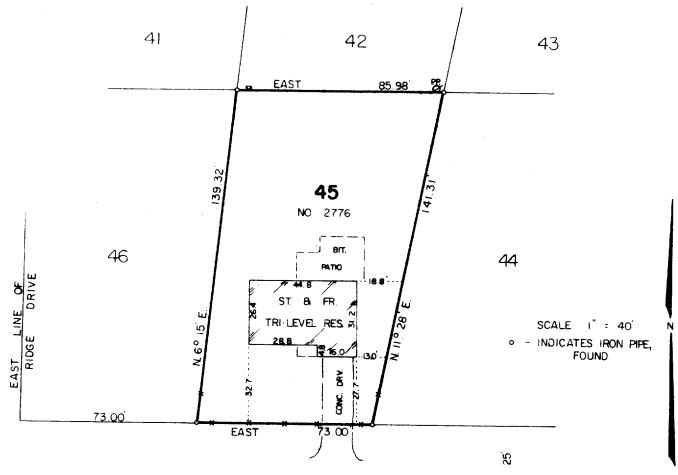

FRONTAGE	ROAD	
		.52

,<u>'</u>

Lot 45, Lynndale Subdivision, Village of East Troy, Walworth County, Wisconsin.

CERTIFICATION

STATE OF WISCONSIN SS

I HAVE SURVEYED THE ABOVE DESCRIBED PROPERTY AND THE ABOVE MAP IS A TRUE REPRESENTATION THEREOF AND SHOWS THE SIZE AND LOCATION OF THE PROPERTY, ITS EXTERIOR BOUNDARIES, THE LOCATION AND DIMENSIONS OF ALL VISIBLE STRUCTURES THEREON, FENCES. APPARENT EASEMENTS AND ROAD WAYS AND VISIBLE ENCROACHMENTS, IF ANY.

THIS SURVEY IS MADE FOR THE EXCLUSIVE USE OF THE PRESENT OWNERS OF THE PROPERTY, AND ALSO THOSE WHO PURCHASE, MORTGAGE, OR GUARANTEE THE TITLE THERETO, WITHIN ONE (1) YEAR FROM DATE HEREOF, AND AS TO THEM I WARRANT THE ACCURACY OF SAID SURVEY AND MAP.

DATE FEBRUARY 20 1975 REVISED - JUNE 21 , 1984. PONALD H ZIMMERMAN S 8



2-947