
Date November 21, 1984

## **PLAT OF SURVEY**

Job No. Z-20-31619

LOT 53 - LYNNDALE SUBDIVISION ADDITION NO. 1 being a subdivision located in the Southwest of the Northwest 1/4 of Section 20, Town 4 North, Range 18 East, Village of East Troy, Walworth County, Wisconsin.

Located at 1882 Fremont Street

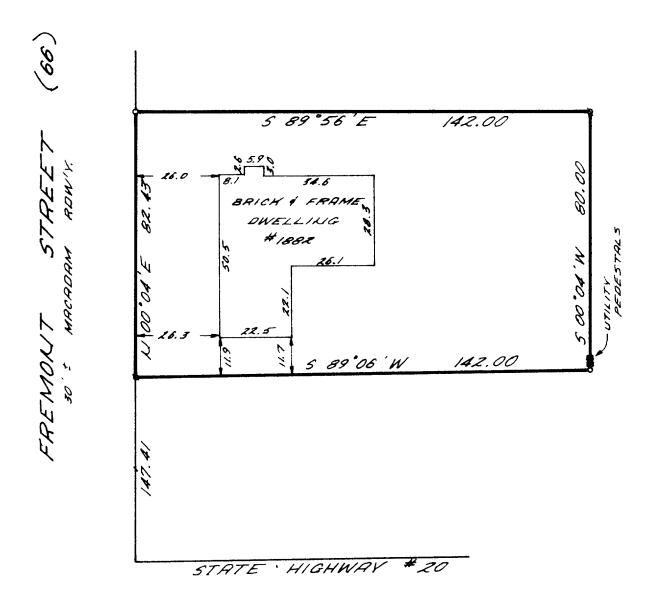

Owner: Michael Reiter

B - FOUND IRON PIPE

o - SET IRON PIPE

8522 West Lisbon Avenue Milwaukee, Wisconsin 53222

SURVEYED FOR

Norwest Mortgage Inc. P. O. Box 26144 Milwaukee, WI. 53226

## LANDMARK SURVEYING CO.

I, Richard J. Lammi, surveyed the above described property, and the above map is a true representation thereof and shows the size and location of the property, its exterior boundaries, the location and dimensions of all visible structures thereon, fences, apparent easements, roadways and visible encroachments.

This survey is made for the exclusive use of the present owners of the property; also those who purchase, mortgage or guarantee the title thereto, within one year from date hereof.

REGISTERED LAND SURVEYOR NO. 5-777 - STATE OF WISCONSIN

PHONE 461-3730

