

Cade Homes, Inc.
Eugene & Sandra Chaignot


PLAT OF SURVEY

LOCATION: Lilly Street, East Troy, Wisconsin

LEGAL DESCRIPTION: Lot 72 in TROYJEN'S ADDITION NO. 1, located in the NW 1/4 of the SW 1/4 and the SW 1/4 of the SW 1/4 of Section 19, Town 4 North, Range 18 East, of the Fourth Principal Meridian, Village of East Troy, Walworth County, Wisconsin.

April 14, 1986

Survey No. 66556

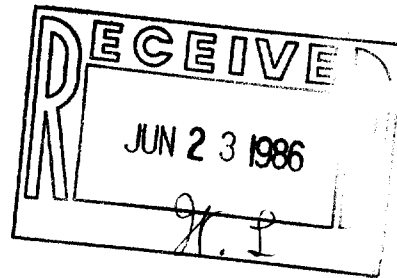

S 0°03'15" E
191.06

10' UTILITY EASEMENT

FIN. GRD. 112.92

193.45
N 50°41'49" E

28.53

51.60

UNDER
CONST.

7.22

20.15

30.05

28.80

20.00

53.15

22.77

35.38

35.46

22.97


149.78
S 89°51'58" W

68.87

N 0°04'44" W

SUPERIOR
AVE.

LILLY ST.

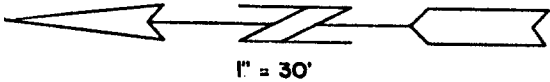

1" = 30'

METROPOLITAN SURVEY SERVICE, INC.

REGISTERED LAND SURVEYORS

11000 W. JANESVILLE RD. HALES CORNERS, WI 53130

529-5380

I HEREBY CERTIFY THAT I HAVE SURVEYED THE ABOVE DESCRIBED PROPERTY AND THAT THE ABOVE MAP IS A TRUE REPRESENTATION THEREOF AND SHOWS THE SIZE AND LOCATION OF THE PROPERTY, ITS EXTERIOR BOUNDARIES, THE LOCATION OF ALL VISIBLE STRUCTURES AND DIMENSIONS OF ALL PRINCIPAL BUILDINGS THEREON, BOUNDARY FENCES, APPARENT EASEMENTS AND ROADWAYS AND VISIBLE ENCROACHMENTS, IF ANY.

THIS SURVEY IS MADE FOR THE EXCLUSIVE USE OF THE PRESENT OWNERS OF THE PROPERTY, AND ALSO THOSE WHO PURCHASE, MORTGAGE, OR GUARANTEE THE TITLE THERETO WITHIN ONE (1) YEAR FROM DATE HEREOF.

SIGNED

Gerald E. Casey
Registered Land Surveyor S-1329

66-073