



#89-68

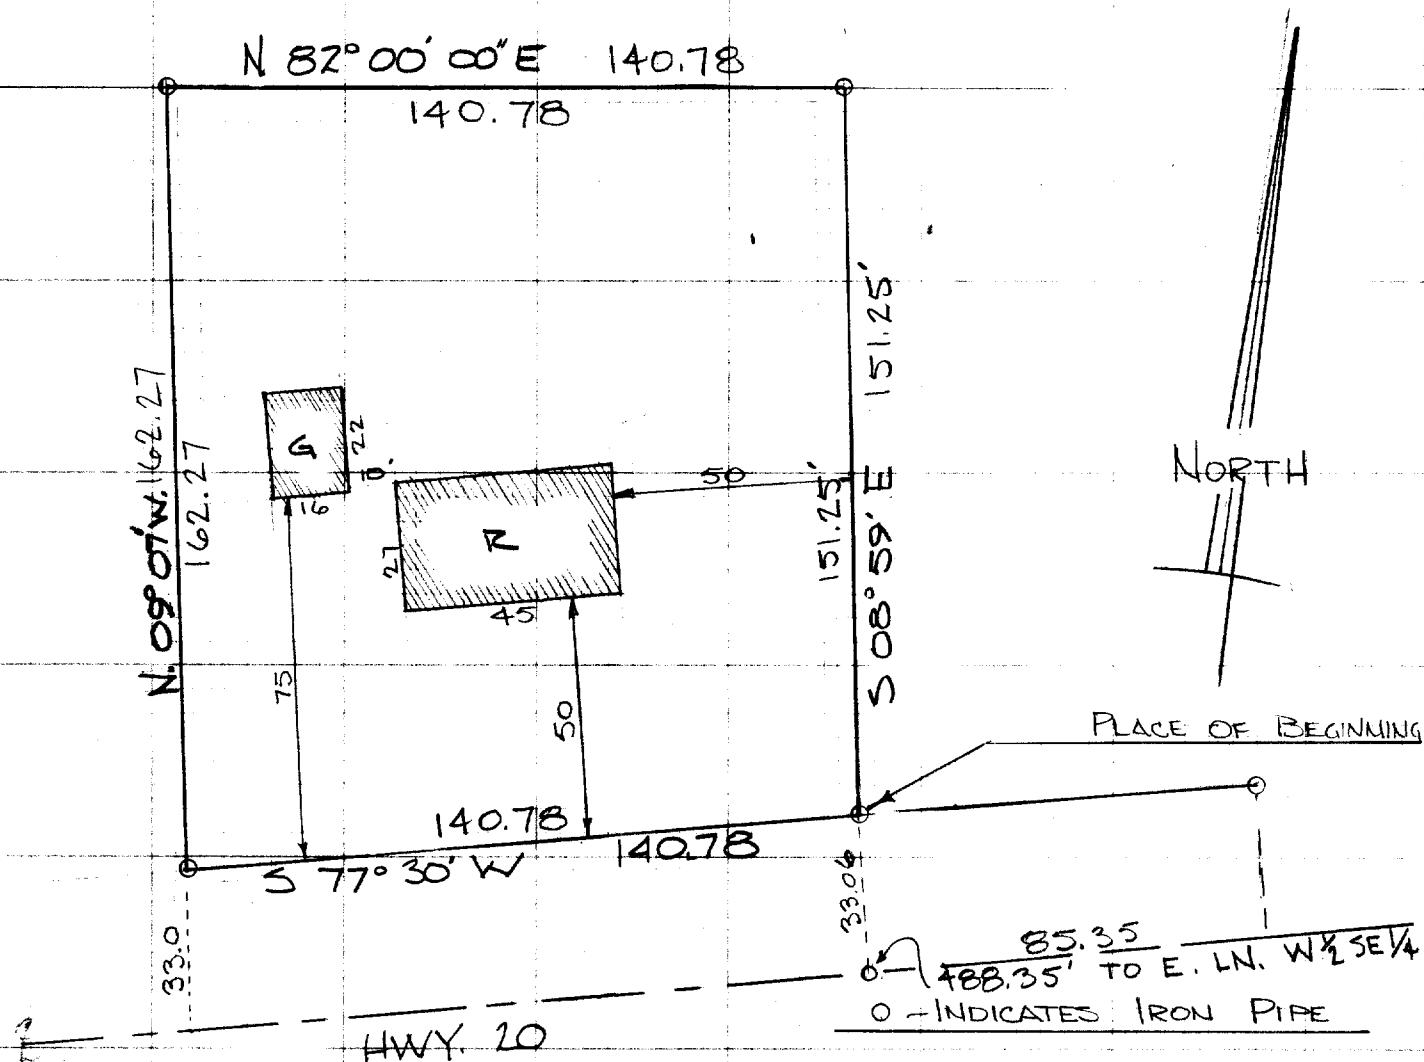

DESCRIPTION: Commencing at the point of intersection of the center line of S.T.Hwy. #20 and the East line of the  $W\frac{1}{4}$  of the SE $\frac{1}{4}$  of Section 19, T. 4 N., R. 18 E., Walworth County, Wisconsin, thence SW'ly along the center line of S.T.Hwy #20, 488.35 feet, thence N. 08° 59' W. 33.00 feet to the place of beginning of the lands hereinafter described, to wit: thence S. 57° 30' W. along the N'ly. ROW line of said Hwy. 140.78 feet, thence N. 08° 59' W. 162.27 feet, thence N. 82° 09' 00" E. 140.78 feet, thence S. 08° 59' E. 151.25 feet to the place of beginning.

CERTIFICATE: I, James F. Biagi, ~~surveyor~~, do hereby certify that I have surveyed the property herein described.

August 1, 1968.

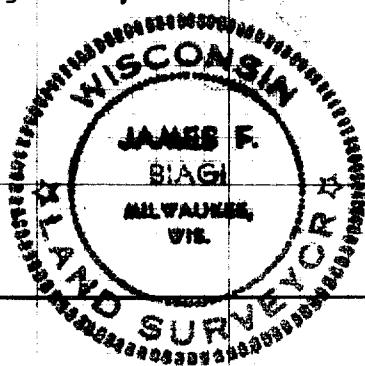

James F. Biagi, RLS 272