


Plat of Survey



Commencing at the Northeast corner of Lot 1, in Block 16 of the Village of East Troy, running thence West along the North line of said lot to the Northwest corner of same; thence South along the West line of said lot 58 feet; thence East to the East line of said lot; thence North along the East line of said lot 58 feet to the place of beginning, being the North 58 feet in width of said Lot 1, excepting and reserving therefrom the East 96 feet thereof. Said land being in the Village of East Troy, Walworth County, Wisconsin.

ORDERED BY: John Redel
Main Street Realty
2874 Main St. Box 419
East Troy, WI 53120
(414) 642-7238

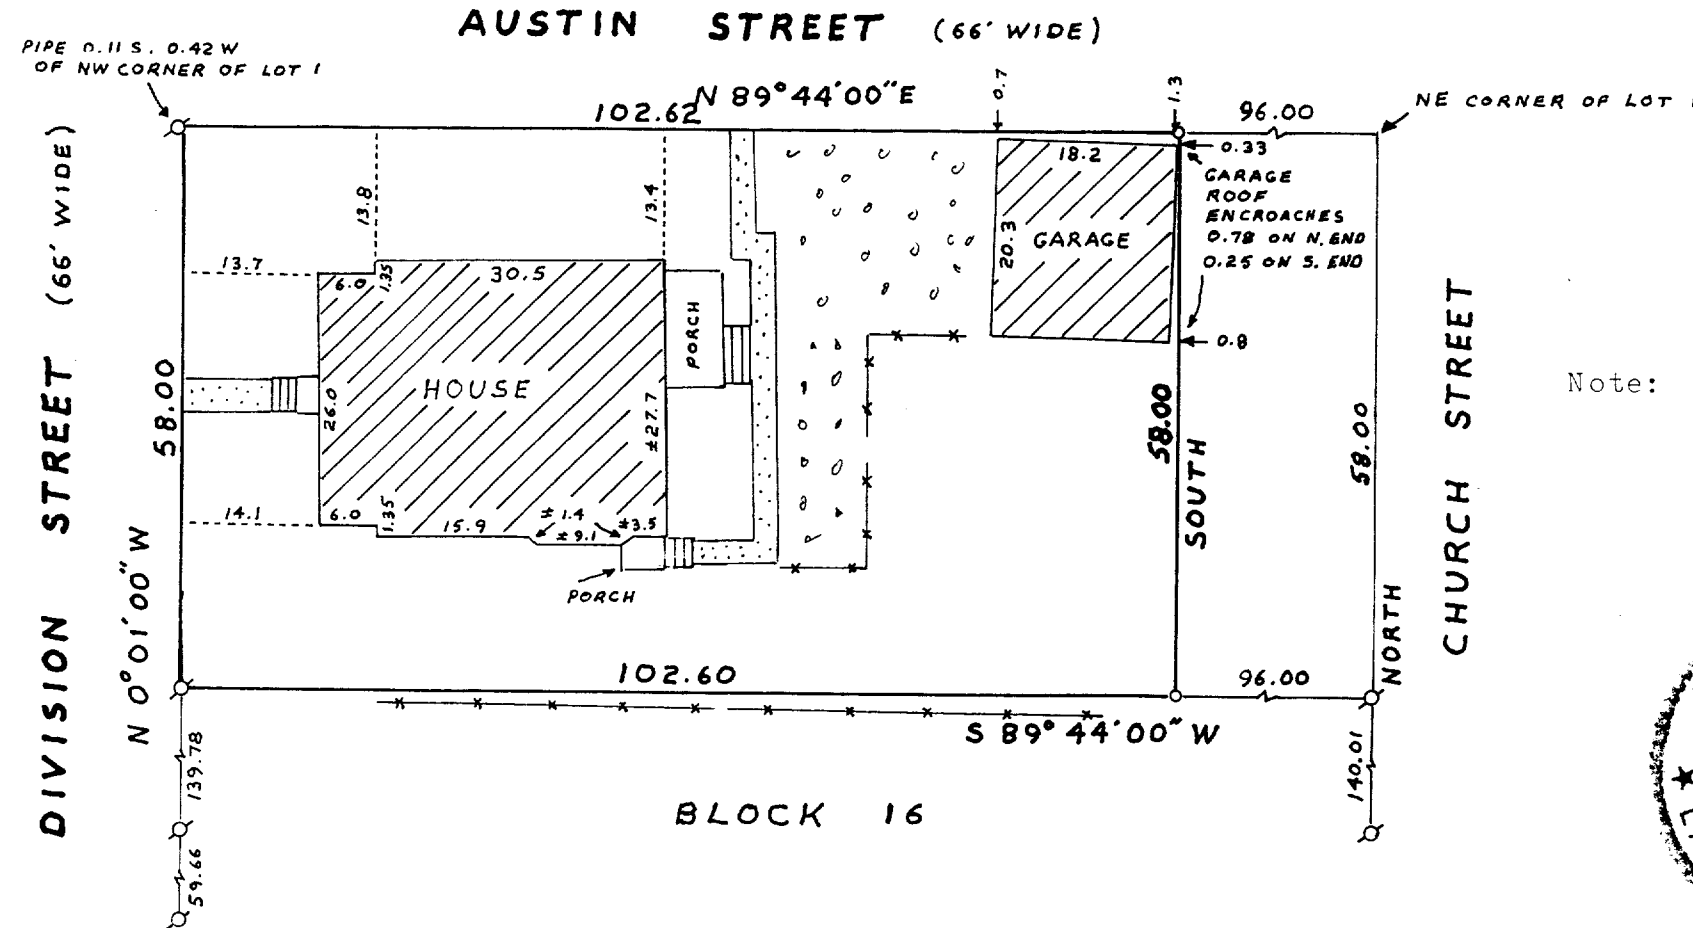

Bearings referenced to the west line of Church St. assumed as NORTH

Note: Dimensions near Southeast house corner are approximate due to dog.

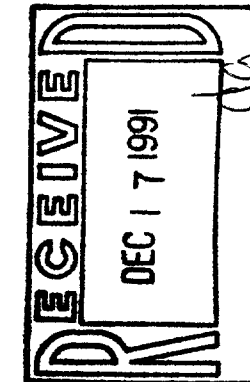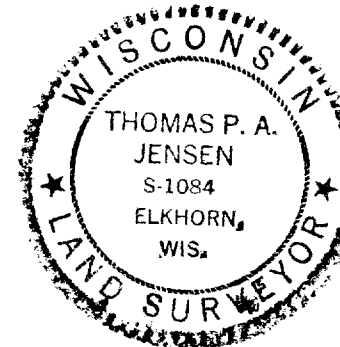

Copyright © 1990 by Jensen Surveying & Mapping S.C.

All rights reserved. No part of this survey plat may be reproduced or transmitted in any form by any means - graphic, electronic, or mechanical, including photocopying, tracing, or information storage and retrieval systems - without permission in writing from Thomas P.A. Jensen, Jensen Surveying & Mapping S.C.

Note: This survey plat is not certified unless signed and sealed in red ink.

I, Thomas P.A. Jensen, Wisconsin Registered Land Surveyor, do hereby certify that this survey was performed by me, or under my direction, in full compliance with the owner's/agent's instructions and Chapter A-E 7 of the Wisconsin Administrative Code "Minimum Standards For Property Surveys"; and that this map is an accurate representation thereof to the best of my knowledge and belief.

Thomas P.A. Jensen
Thomas P.A. Jensen R.L.S-1084
Jensen Surveying & Mapping S.C.

Legend

- Found iron pipe
- Set iron rod 3/4 dia.
- Recorded as dimension
- Fence
- Gravel surface
- concrete surface

Jensen Surveying & Mapping S.C.

45 South Wisconsin Street P.O. Box 322
Elkhorn, Wisconsin. 53121.
(414) 723-3434

Mapping date: 12/19/90.

Revisions:

Sheet 1 of 1 Sheets

Job reference number: 1990.189

Scale: 1" = 20'

