
PLAT OF SURVEY -0F-

LOT 5, MARION SUBDIVISION, located in the Northwest 1/4 of the Northwest 1/4 of Section 29, Township 4 North, Range 18 East in Walworth County, Wisconsin.

Proposed house was staked on actual corners with 5 foot control on the longest house line. The Contractor will be responsible to field verify all stakes for location and dimension prior to construction. If any discrepancies should arise, notify this office at once.

Survey For: Denise Pohlman

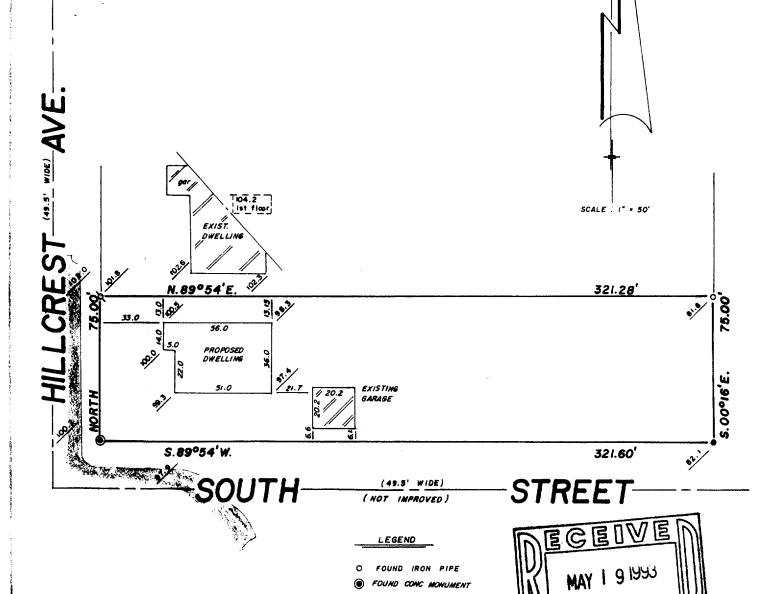

FOUND IRON PIPE FOUND CONC MONUMENT

SET IRON PIPE



B.W. SURVEYING

Land Surveys Mapping And Planning 35117 Academy Road Burlington, Wisconsin 53105 (414) 534-4109

"I hereby certify that I have surveyed the above described property and that the above map is a true representation thereof and shows the size and location of the property, its exterior boundaries, the location of all visible structures and dimensions of all principal buildings thereon, boundary fences, apparent easements, roadways and encroachments, if any."

"This survey is made for the use of the present owners of the property, and those who purchase, mortgage, or guarantee the title thereto within one year from date hereof."



THIS IS NOT AN ORIGINAL PRINT UNLESS THIS SEAL IS RED

REGISTERED LAND SURVEYOR - 1778

MARCH_II, 1993 DATE

JOB NUMBER

003-382


PLAT OF SURVEY

LOT 5, MARION SUBDIVISION, located in the Northwest 1/4 of the Northwest 1/4 of Section 29, Township 4 North, Range 18 East in Walworth County, Wisconsin.

Proposed house was staked on actual corners with 5 foot control on the longest house line. The Contractor will be responsible to field verify all stakes for location and dimension prior to construction. If any discrepancies should arise, notify this office at once.

Survey For: Denise Pohlman

I hereby certify that the existing foundation shown on this plat of survey is located as shown thus (), dated this 20th day of May, 1993.

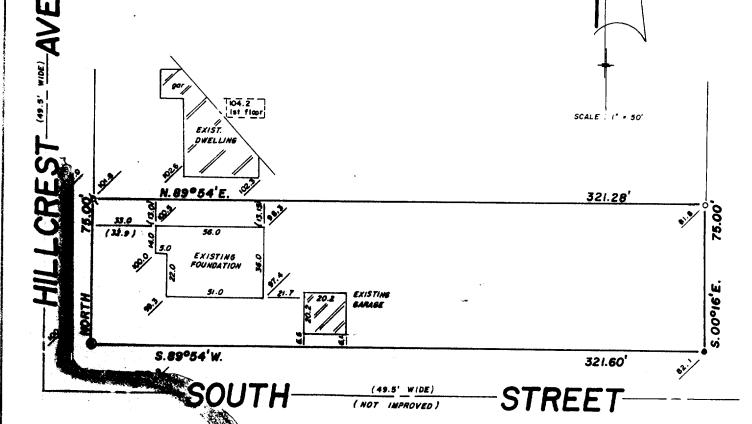

LEGEND

FOUND IRON PIPE


FOUND 2" IRON PIPE

FOUND CONC MONUMENT



B.W. SURVEYING

Land Surveys Mapping And Planning 35117 Academy Road Burlington, Wisconsin 53105 (414) 534-4109

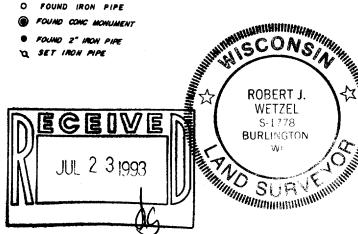

"I hereby certify that I have surveyed the above described property and that the above map is a true representation thereof and shows the size and location of the property, its exterior boundaries, the location of all visible structures and dimensions of all principal buildings thereon, boundary fences, apparent easements, roadways and encroachments, if any."

"This survey is made for the use of the present owners of the property, and those who purchase, mortgage, or guarantee the title thereto within one year from date hereof."

RMS-4

THIS IS NOT AN ORIGINAL PRINT UNLESS THIS SEAL IS RED

REGISTERED LAND SURVEYOR - 1778

MARCH II, 1993 DATE

JOB NUMBER