
LOT 1, CERTIFIED SURVEY MAP No. 2033, being a redivision of Lot ! of Certified Survey Map No. 1670, located in the Northeast 1/4 of Section 30, Township 4 North, Range 18 East in the Village of East Troy, Walworth County, Wisconsin.

Survey For: Hackbarth Builders

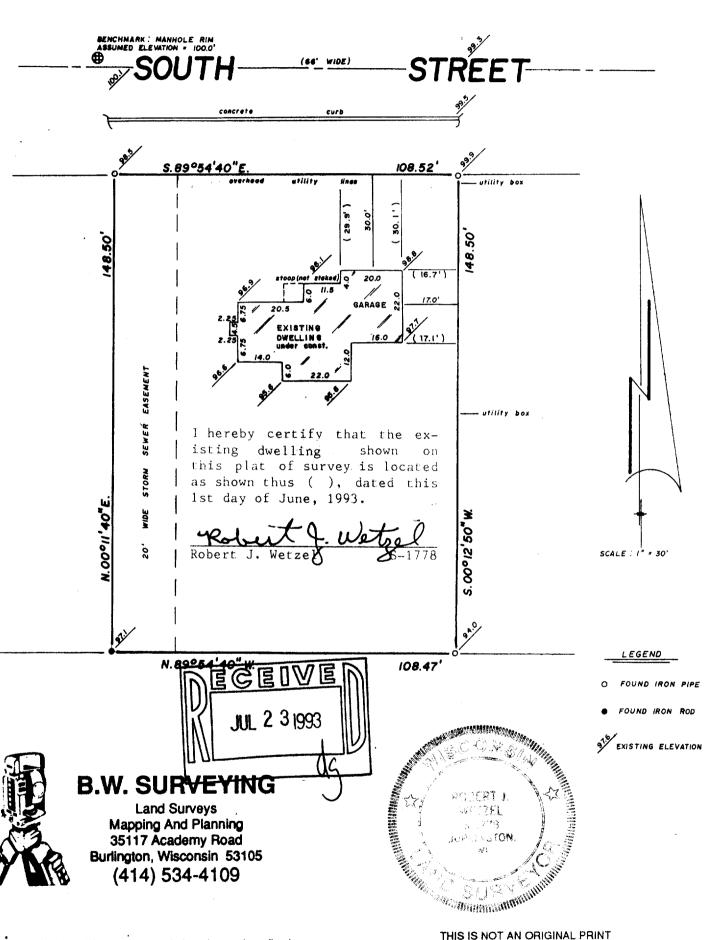

"I hereby certify that I have surveyed the above described property and that the above map is a true representation thereof and shows the size and location of the property, its exterior boundaries, the location of all visible structures and dimensions of all principal buildings thereon, boundary fences, apparent easements, roadways and encroachments, if any.

"This survey is made for the use of the present owners of the property, and those who purchase, mortgage, or guarantee the title thereto within one year from date hereof."

RA-2033-1

THIS IS NOT AN ORIGINAL PRINT UNLESS THIS SEAL IS RED

ROBERT J. WETZEL

**REGISTERED LAND SURVEYOR - 1778** 

Revised: 4/13/93


MARCH 31, 1993 DATE

JOB NUMBER

003386

LOT 1, CERTIFIED SURVEY MAP No. 2033, being a redivision of Lot 1 of Certified Survey Map No. 1670, located in the Northeast 1/4 of Section 30, Township 4 North, Range 18 East in the Village of East Troy, Walworth County, Wisconsin.

Survey For: Hackbarth Builders

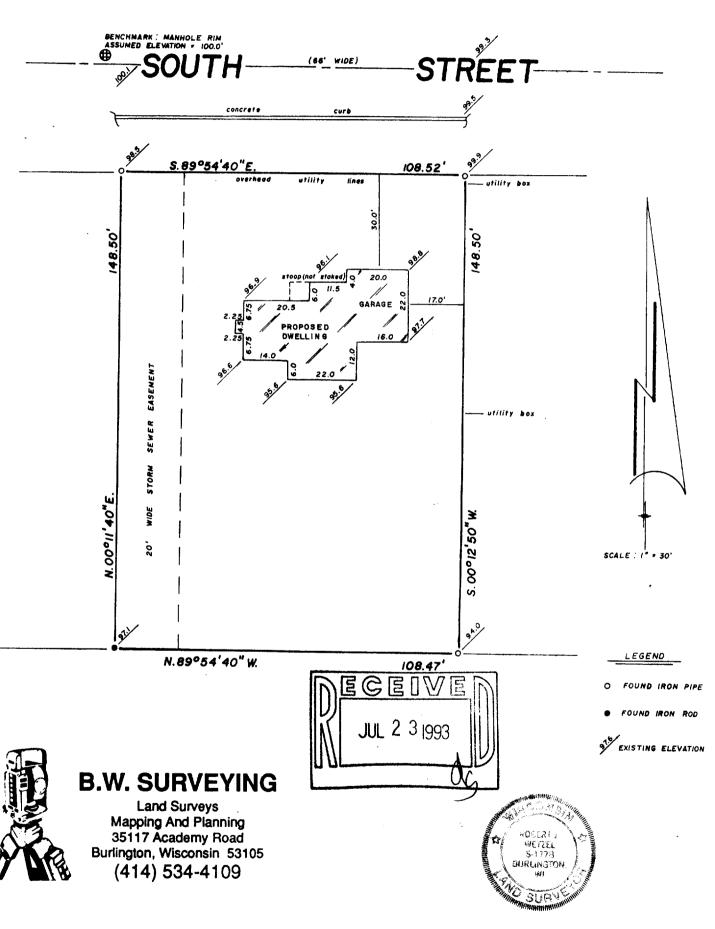

"I hereby certify that I have surveyed the above described property and that the above map is a true representation thereof and shows the size and location of the property, its exterior boundaries, the location of all visible structures and dimensions of all principal buildings thereon, boundary fences, apparent easements, roadways and encroachments, if any."

"This survey is made for the use of the present owners of the property, and those who purchase, mortgage, or guarantee the title thereto within one year from date hereof."

THIS IS NOT AN ORIGINAL PRINT UNLESS THIS SEAL IS RED

ROBERT J. WETZEL

REGISTERED LAND SURVEYOR - 1778

Ravised: 4/13/93

MARCH: 31, 1993 DATE

JOB NUMBER