


Rt. 3, Box 273  
Elkhorn, Wisconsin 53121  
Phone: (414) 723-4260 (office)  
(414) 723-4813 (residence)

LOT 18 OF GLENN VIEW ESTATES  
SUBDIVISION LOCATED IN THE NW  
1/4 AND THE NE 1/4 OF THE NW  
1/4 OF SECTION 20, T4N, R18E,  
VILLAGE OF EAST TROY,  
WALWORTH COUNTY, WISCONSIN.

C.S.M. 576

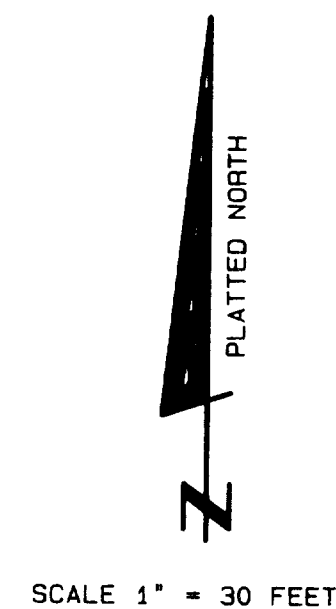

1 FOUND IRON PIPE  
 2 FOUND IRON ROD  
 3 FOUND BRASS CAPPED MONUMENT  
 4 FOUND CONCRETE MONUMENT  
 + CHISEL CUT IN CONCRETE  
 ● SET IRON ROD, 24" LONG, WEIGHING  
 1.5 LBS./LINEAL FT., 3/4" DIA.  
 ● SET IRON ROD, 30" LONG, WEIGHING  
 4.5 LBS./LINEAL FT., 1-11/16" DIA.  
 (xx) RECORDED AS DIMENSION  
 —X—X— EXISTING FENCE

"I hereby certify that I have surveyed the above described property and that the above map is a true representation thereof and shows the size and location of the property, its exterior boundaries, the location of all visible structures and dimensions of all principal buildings thereon, boundary fences, apparent easements, roadways and visible encroachments, if any."

"This survey was made for the use of the present owners of the property and also those who purchase, mortgage, or guarantee the title thereto within one year from the date hereof."

"This survey is made for the use of the present owners of the property, and also those who purchase, mortgage, or guarantee the title thereto within one year from date hereof."

*Kenneth B. Albrecht*

KENNETH B. ABERNATHY, JR.  
WISCONSIN REGISTERED LAND SURVEYOR,  
S-1594

Date: 3/1/94 Job No. 94.219

003-406