

ABERNATHY and ASSOCIATES

Kenneth B. Abernathy Jr.


Wisconsin Registered Land Surveyor S-1594

Rt. 3, Box 273
Elkhorn, Wisconsin 53121
Phone: (414) 723-4260 (office)
(414) 723-4813 (residence)

PLAT OF SURVEY

LOT 74 OF FOURTH ADDITION TO GLENN
VIEW ESTATES SUBDIVISION, LOCATED IN
THE NORTHWEST 1/4 OF SECTION 20,
TOWN 4 NORTH, RANGE 18 EAST, VILLAGE
OF EAST TROY, WALWORTH COUNTY,
WISCONSIN.

ORDERED BY: NEUMANN DEVELOPMENTS, INC.
SUITE 206
4450 MILTON AVENUE
JANESVILLE, WISCONSIN 53546

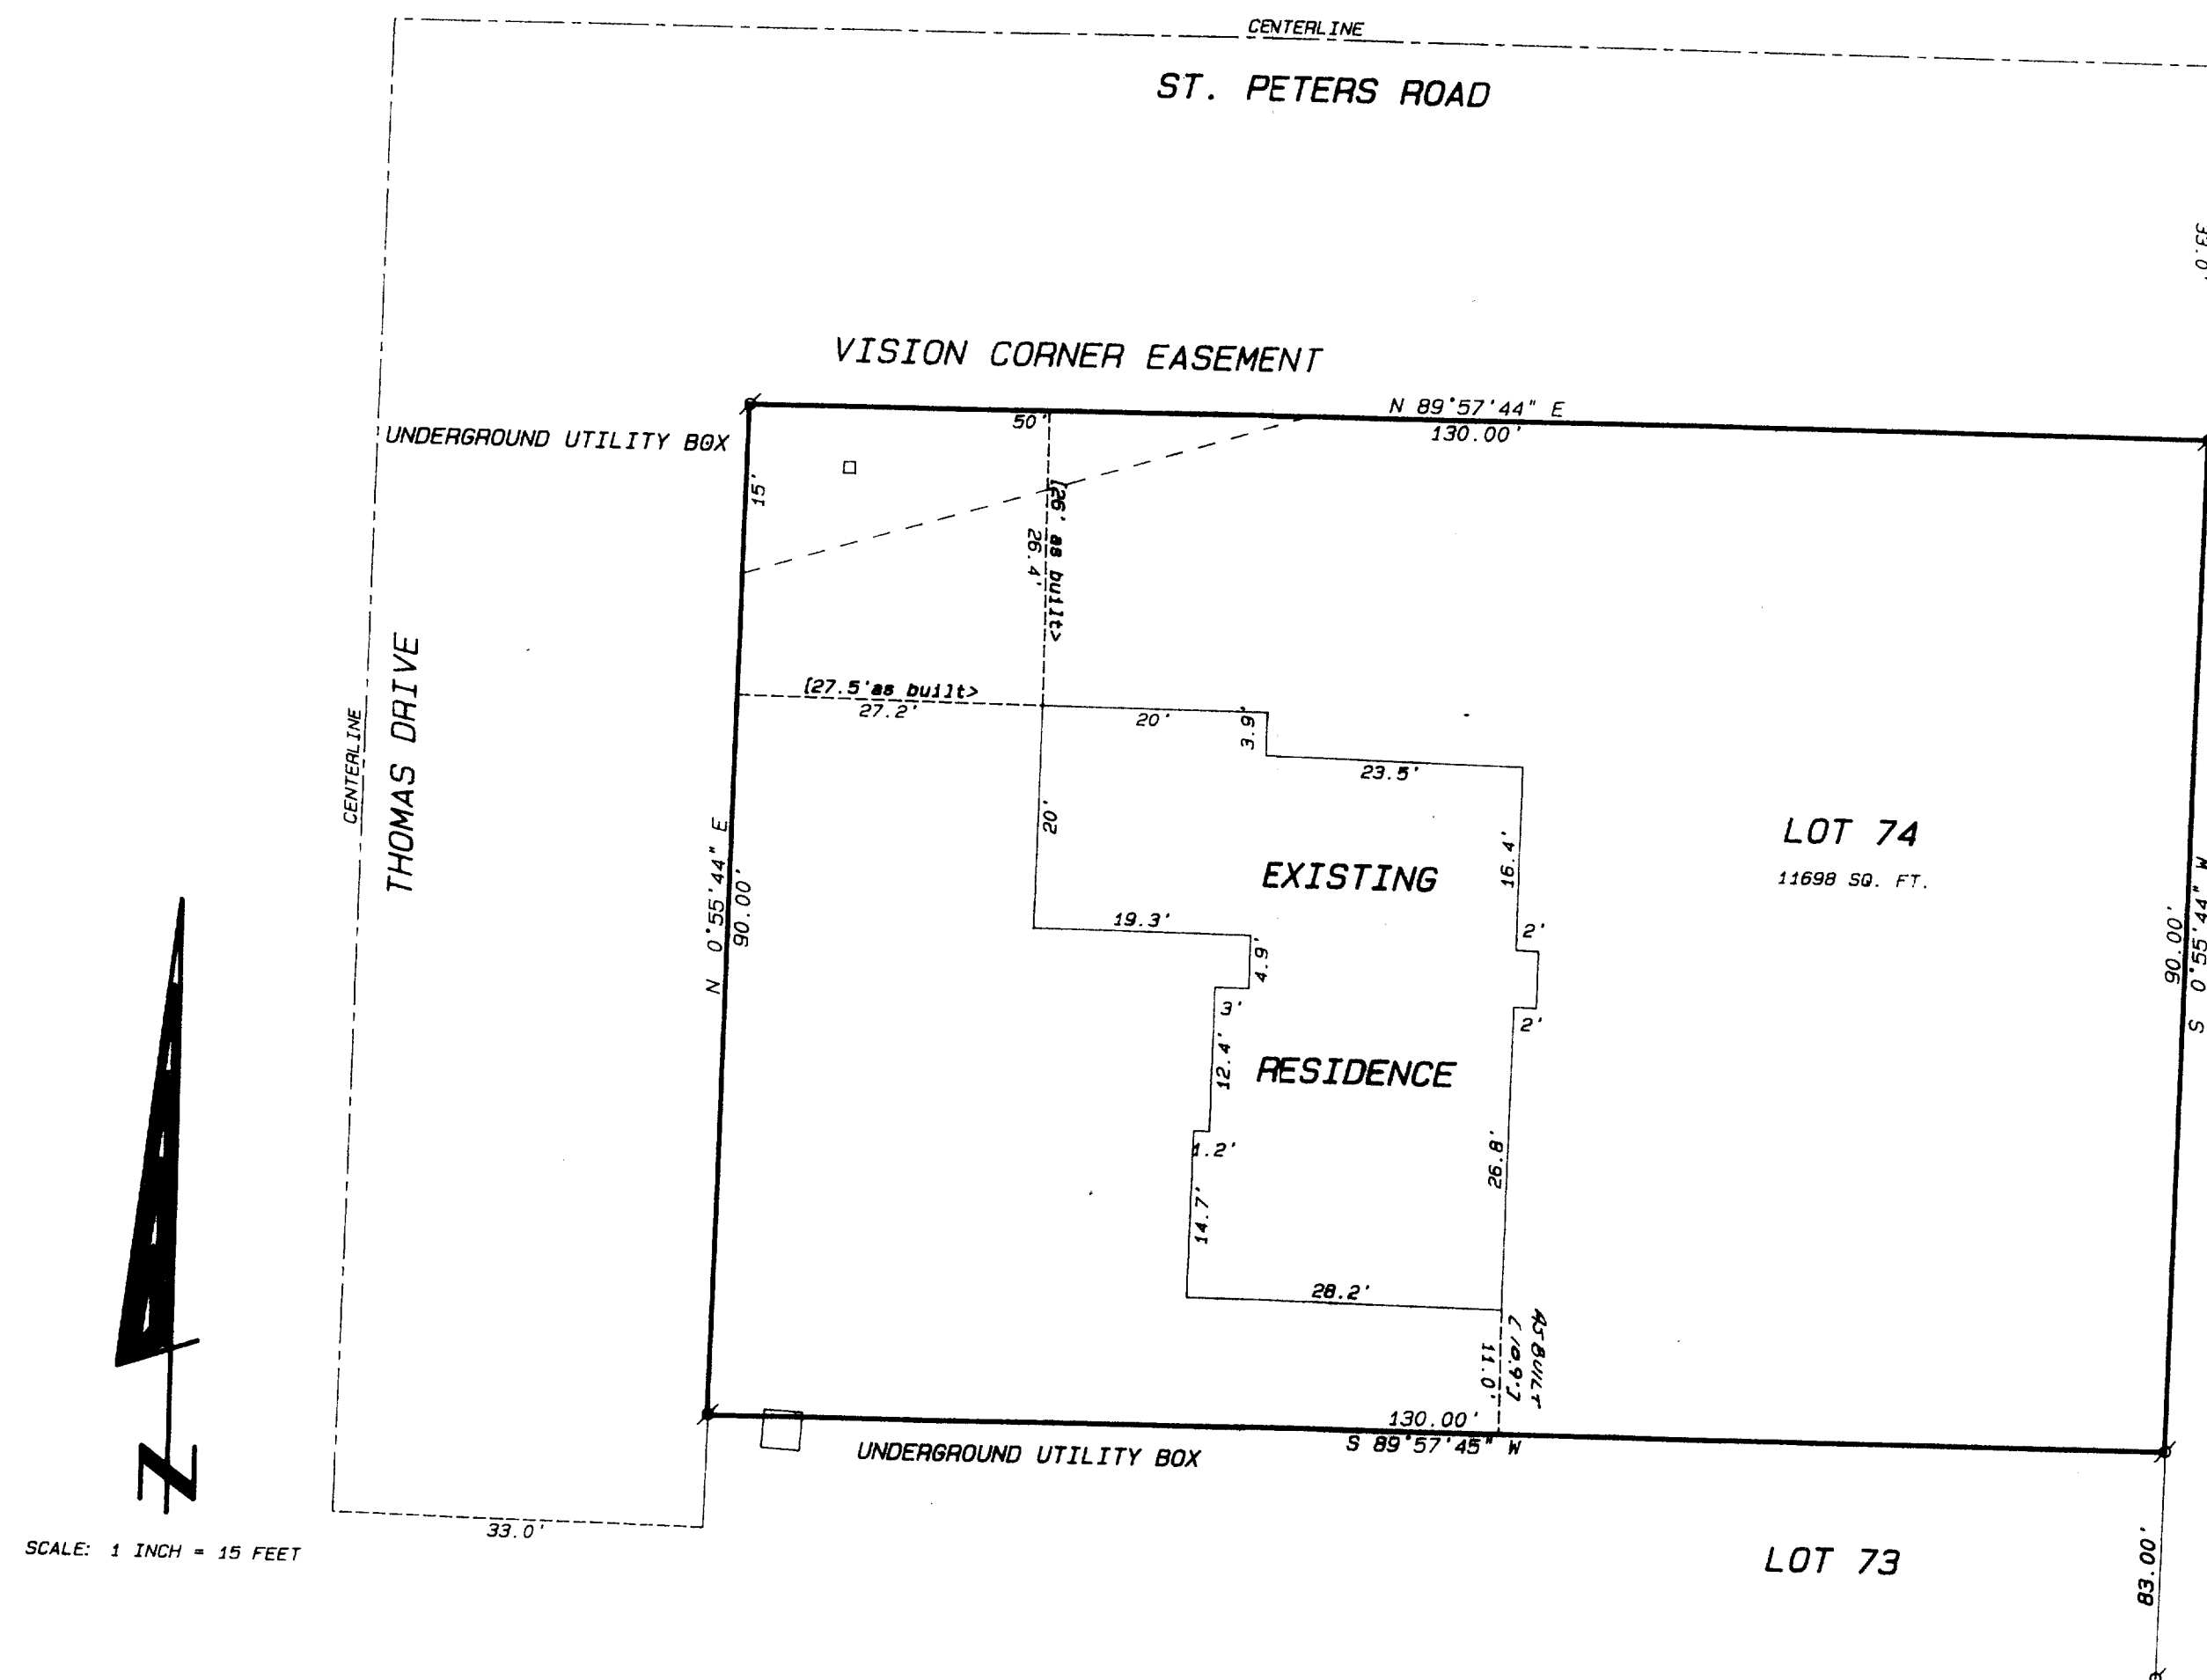

LOT 20
FIRST ADD.
GLENN VIEW
ESTATES

Legend

- FOUND IRON PIPE
- FOUND IRON ROD
- FOUND BRASS CAPPED MONUMENT
- FOUND CONCRETE MONUMENT
- CHISEL CUT IN CONCRETE
- SET IRON ROD, 24" LONG, WEIGHING 1.5 LBS./LINEAL FT., 3/4" DIA.
- SET IRON ROD, 30" LONG, WEIGHING 4.5 LBS./LINEAL FT., 1-11/16" DIA.
- RECORDED AS DIMENSION
- EXISTING FENCE




SCALE: 1" = 15 FEET

"I hereby certify that I have surveyed the above described property and that the above map is a true representation thereof and shows the size and location of the property, its exterior boundaries, the location of all visible structures and dimensions of all principal buildings thereon, boundary fences, apparent easements, roadways and visible encroachments, if any."

"This survey is made for the use of the present owners of the property, and also those who purchase, mortgage, or guarantee the title thereto within one year from the date hereof."

Kenneth B. Abernathy, Jr.
KENNETH B. ABERNATHY, JR.
WISCONSIN REGISTERED LAND SURVEYOR,
S-1594

Date: MAY 10, 1994 Job No. 94.501

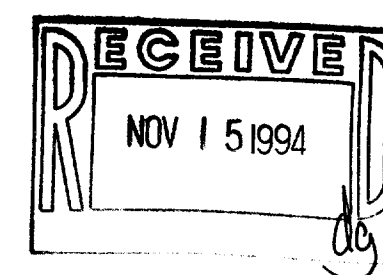

AS BUILT COMPLETED 9/7/94

RAW-74

113-1128