
ABERNATHY and ASSOCIATES Kenneth B. Abernathy Jr.

Wisconsin Registered Land Surveyor 5-1594

Rt. 3, Box 273 Elkhorn, Wisconsin 53121

Phone: (414) 723-4260 (office) (414) 723-7209 (FAX)

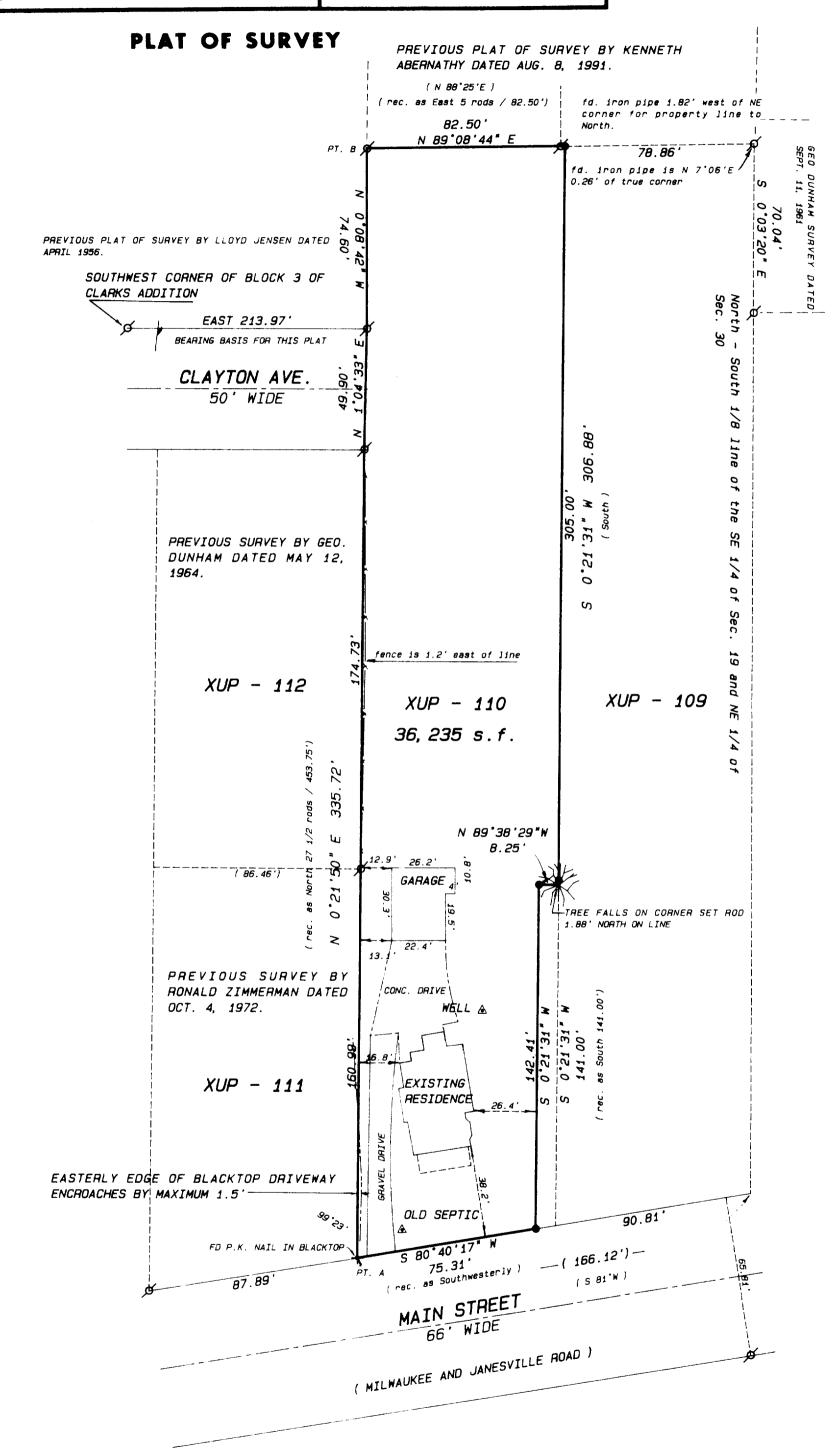

LEGAL DESCRIPTION: (RECORDED IN VOL. 491 OF DEEDS P. 100)

Commencing at a point South 81° West 166 and 12/100 feet from point where North side of Milwaukee and Janesville Road crosses 1/8 section line between East and West 1/2 of Northeast 1/4 of Section 30 T. 4 N., R. 18 E., thence North 27 1/2 rods along the East line of lands owned by Mary Bemis to the South line of land owned by estate of David Gleason, thence East 5 rods, thence South to a point 159 feet North from North side of above mentioned road, thence West 8 1/4 feet; thence South to North side of said road; thence Southwesterly along North side of said road to the place of beginning, part of above described land being in SE 1/4 of Section 19 Township and Range aforesaid.

Also commencing at a point on East side of lands formerly owned by John M. Brewster, which point is 159 feet North from North side of Milwaukee and Janesville Road, running thence South 18 feet, thence West 8 1/4 feet to Brewsters East line, thence North 18 feet, thence East 8 1/4 feet to the place of beginning, being part of Northeast 1/4 of Section 30, T. 4 N., R. 18 E.

OWNER: DORIS CARTER 3010 MAIN STREET EAST TROY, WI. 53120

2.2'

ORDERED BY: STEVE BERGELIN C/O WAUWATOSA REALTY 2212 E. MORELAND BLVD. WAUKESHA, WI. 53186

RESIDENCE DETAIL

PORCH



SCALE 1" = 40 FEET

BEARINGS ARE BASED ON PREVIOUS PLATS OF SURVEY OF RECORD.

PORCH

3.7'

ECEIVER

MAR 2 | 1996

2.7'

SURVEYOR'S COMMENTS: THE ORIGINAL DESCRIPTION CALLS THE NEST LINE OF THE SUBJECT PROPERTY AS NORTH 27 1/2 RODS (453.75'). SEVERAL MONUMENTS FROM SURVEYS ON RECORD WERE FOUND ALONG THIS WEST LINE AND ACCEPTED BY THIS SURVEY. THE LINE FROM PT. A TO PT. B MEASURES N 0°21'31"E 460.21 FEET WHICH IS 6.46 FEET LONGER THAN RECORDED. THE EAST LINE WAS DETERMINED AS PARALLEL WITH LINE AB AND THE RECORD DISTANCE OF 82.50 FEET EAST - WEST WAS HELD.

Legend

FOUND IRON PIPE

FOUND IRON ROD FOUND BRASS CAPPED MONUMENT

FOUND CONCRETE MONUMENT

+ CHISEL CUT IN CONCRETE

● SET IRON ROD, 24" LONG, WEIGHING 1.5 LBS, LINEAL FT., 3'4" DIA.

SET IRON ROD, 30" LONG, WEIGHING

4.5 LBS. LINEAL FT., 1-11/16" DIA. (xx) RECORDED AS DIMENSION

- x--- X- EXISTING FENCE

SCALE: 1"= 40 FEET

KENNETH %. ABERNATHY, JR S-1594 ELKHORN, NO SURVE

by me or under my direction and that the above map is a tri-representation thereof and shows the size and location of the property, i representation thereof and shows the size and detailed the property exterior boundaries the location of all visible structures and dimensions of all principal buildings thereon, boundary fences apparent easements roadways and visible encroachments, if any "This survey is made for the use of the present owners of the property and also those who purchase, mortgage, or guarantee the title thereto within

WISCONSIN REGISTERED LAND SURVEYOR,

Date: JAN 4, 1996