

# Plat of Survey

SCALE 1" = 40'

JAHNKE & JAHNKE ASSOCIATES INC.

Consultants in Engineering, Planning, Subdivisions and Surveying

711 W. MORELAND BLVD. - WAUKESHA, WISCONSIN 53188

TELEPHONE (414) 542-5797 FAX (414) 542-7698

FOR: BIELINSKI BROS. BUILDERS, INC. RE: DEVAGUPTAPU

LEGAL DESCRIPTION: Lot 53, STERLING OAKS, being subdivision of part of the SE 1/4 of the NW 1/4, and part of the NW 1/4 and SW 1/4 of the NE 1/4 of Section 20, Township 4 North, Range 18 East in the Village of East Troy, Walworth County, Wisconsin.

Bench Mark 853.35 (USGS) Hydrant "open" located at northwest corner of Lot 3.

856.3 - Existing elevation

Suggested Residence Grade: First Floor 859.0\*

Top of Foundation 857.8\*

Existing Top of Foundation 857.94

Garage Opening 857.14

1/21/97 - Basement constructed and located as shown.


\*suggested grades only

• Iron pipes found as part of this survey.

NOTE: Expose sanitary sewer lateral before construction to verify gravity flow from the basement.

REFERENCE MERIDIAN: The south line of the NE 1/4 of Section 20 was used as the reference meridian and has an assumed bearing of S88°45'21"W.

SURVEY CERTIFICATE: I have surveyed the above described property and the map shown is a true representation thereof and shows the size and location of the property, its exterior boundaries, the location and dimensions of all visible structures thereon, fences, apparent easements and roadways and visible encroachments if any. This survey is made for the exclusive use of the present owners of the property and also those who purchase, mortgage or guarantee the title thereto within one (1) year from date hereof and as to them I warrant the accuracy of said survey and map.

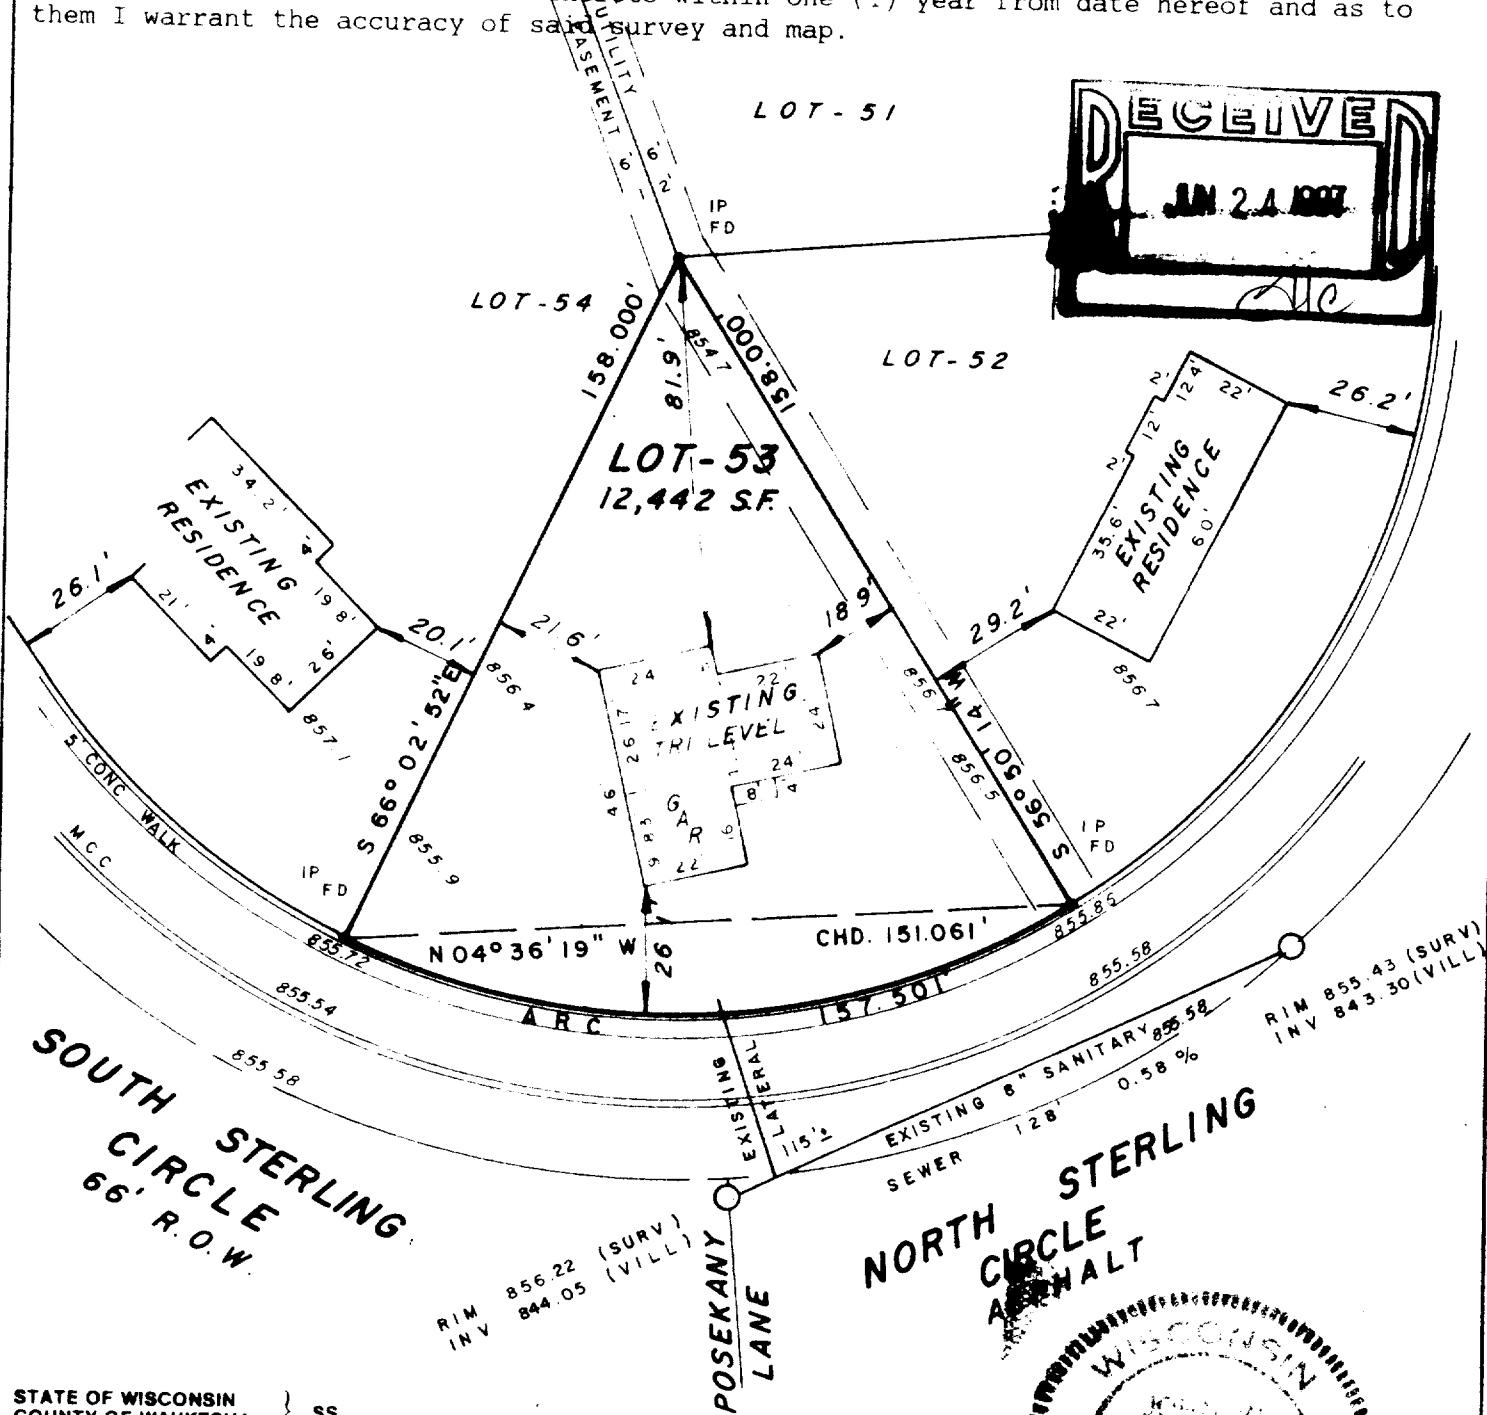

SOUTH STERLING  
CIRCLE  
66' R.O.W.

NORTH STERLING  
CIRCLE  
ASPHALT

POSEKANY  
LANE

STATE OF WISCONSIN }  
COUNTY OF WAUKESHA } SS.

WE, JAHNKE & JAHNKE ASSOCIATES INC., DO HEREBY CERTIFY THAT WE HAVE MADE THIS SURVEY AND THAT THE INFORMATION AS SHOWN ON THE ABOVE PLAT OF SURVEY IS TRUE AND CORRECT REPRESENTATION THEREOF.

REVISION DATE 1/3/97 (DRAWING ONLY) Revised 1/22/97 (Basement Survey)  
1/6/97 (RE-STAKE)

DATED THIS 11th DAY OF December 19 96

PLAT No. P.S. Walworth 203 BOOK Walworth 9 PAGE 36

RICHARD D. JAHNKE - Wis. Reg. No. S-318

JOHN W. JAHNKE, Wis. Reg. No. S-917