

PLAT OF SURVEY

BEING ALL OF LOT 48 OF BROOKSTONE HILLS SUB'D., LOCATED IN THE SW 1/4
OF THE NW 1/4 & NW 1/4 OF THE SW 1/4 OF SECTION 29 AND
NE 1/4 OF THE SE 1/4 AND SE 1/4 & SW 1/4 OF THE NE 1/4 OF
SECTION 30, T.4N., R.18E., VILLAGE OF EAST TROY, WALWORTH COUNTY, WI.

SURVEYOR

NORMAN C. HANSON, RLS 1147
WELCH, HANSON & ASSOC., INC.
W.219 E. WISCONSIN AVE.
NASHOTAH, WI. 53058
(414)387-4225


SURVEY FOR

BROOKSTONE HOMES, INC.
4450 MILTON AVE.
SUITE 208
JANESVILLE, WI 53548

LEGEND

● - 1" IRON PIPE FOUND

MALLARD WAY

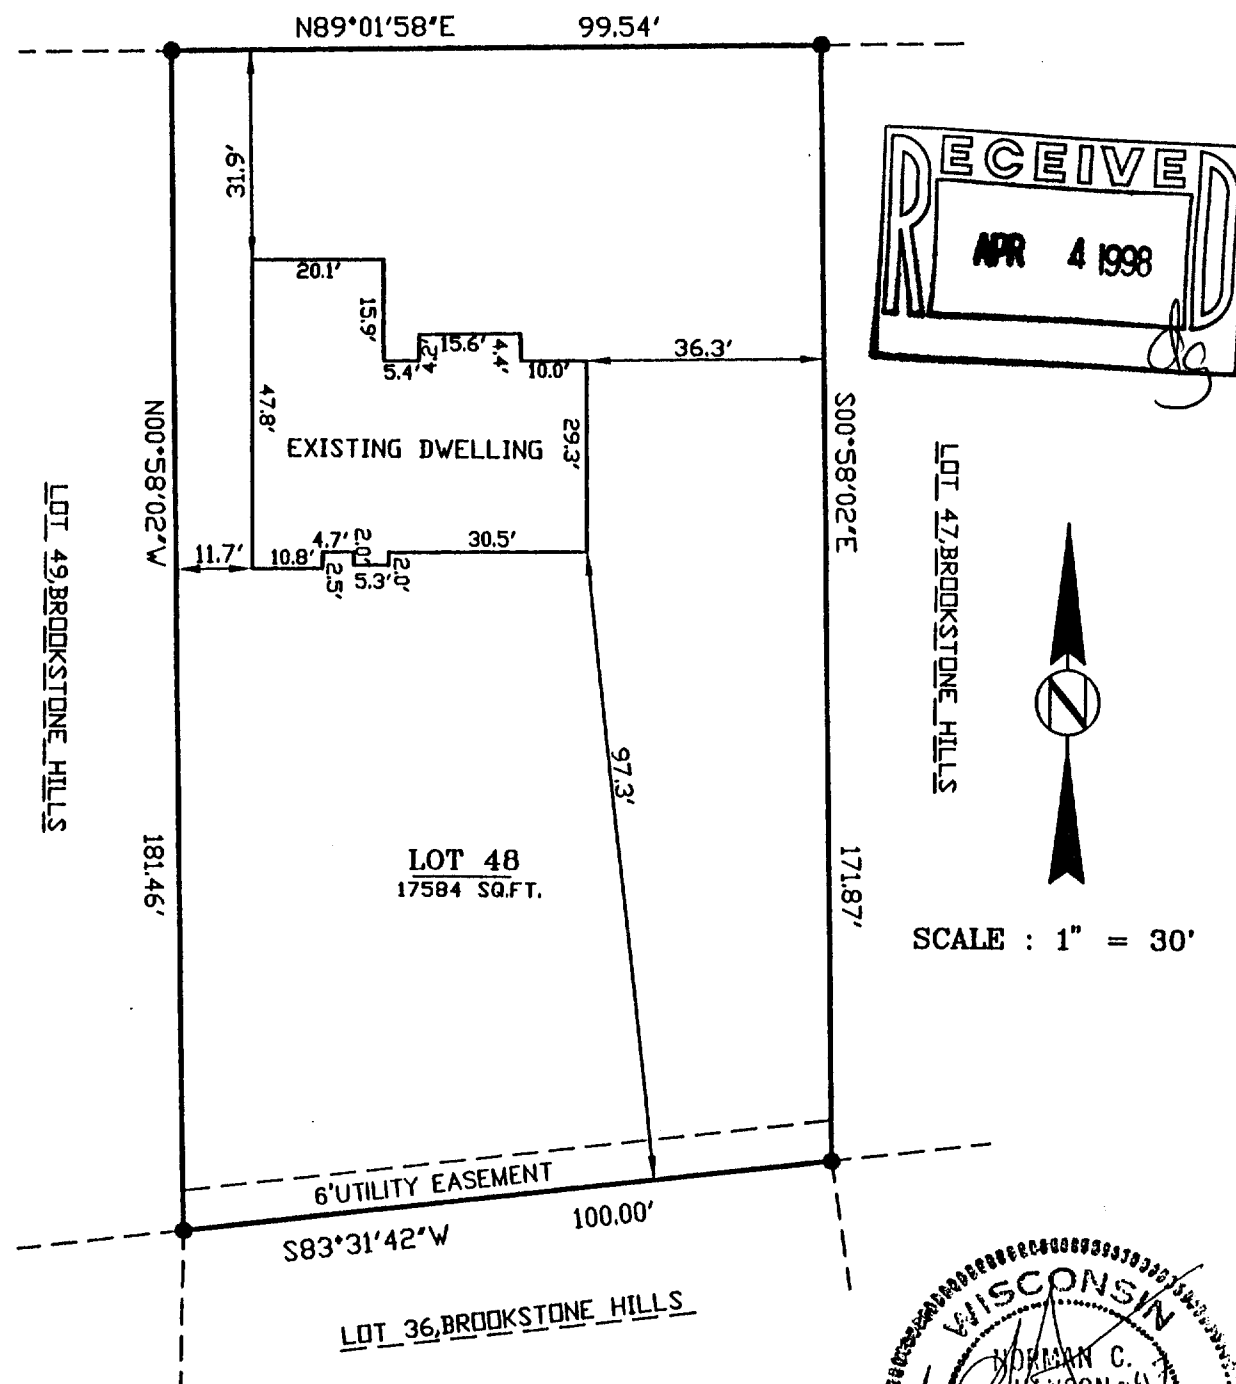

RBR0-48
003-542

SURVEYOR'S CERTIFICATE:

I HEREBY CERTIFY THAT I HAVE SURVEYED THE ABOVE DESCRIBED PROPERTY AND THAT THE ABOVE MAP IS A TRUE REPRESENTATION THEREOF AND SHOWS THE SIZE AND LOCATION OF THE PROPERTY, ITS EXTERIOR BOUNDARIES, THE LOCATION OF ALL VISIBLE STRUCTURES AND DIMENSIONS OF ALL PRINCIPAL BUILDINGS THEREON, BOUNDARY FENCES, APPARENT EASEMENTS, ROADWAYS, AND VISIBLE ENCROACHMENTS, IF ANY.

THIS SURVEY IS MADE FOR THE USE OF THE PRESENT OWNERS OF THE PROPERTY, AND ALSO THOSE WHO PURCHASE, MORTGAGE, OR GUARANTEE THE TITLE THERETO WITHIN ONE (1) YEAR FROM DATE HEREOF.

PROJECT NO. 11135

