
PLAT OF SURVEY

LOT 158, STERLING OAKS ADDITION NO. 1, being a part of the Northwest 1/4 and Southwest 1/4 of the Northeast 1/4 and a part of the Northeast 1/4 and Southeast 1/4 of the Northwest 1/4, all in Section 20, Town 4 North, Range 18 East, Village of East Troy, Walworth County, Wisconsin.

Surveyed for: Bielinski Bros. Builders Inc/ Thomas and Suzanne Chojnacki

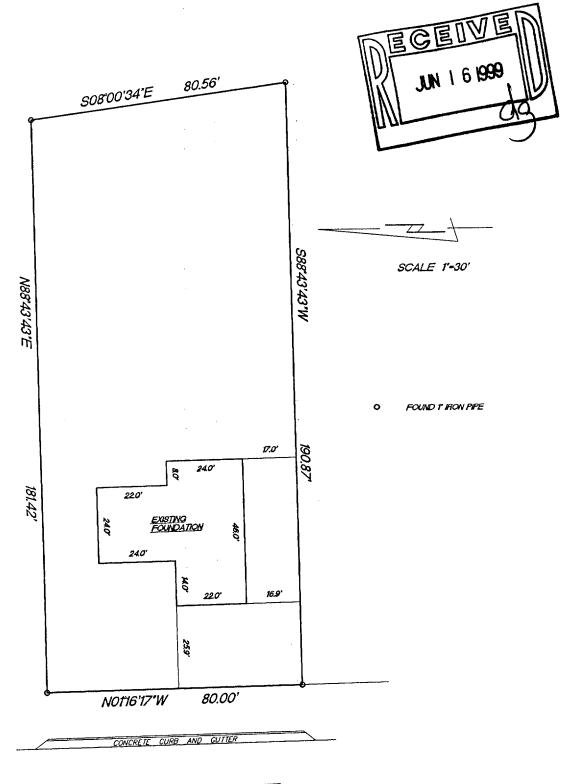

- STEEPLE - DRIVE-

66' WIDE


"I hereby certify that I have surveyed the above described property and that the above map is a true representation thereof and shows the size and location of the property, its exterior boundaries, the location of all visible structures and dimension of all principal buildings thereon, boundary fences, apparent easements, roadways and encroachments if any."

"This survey is made for the use of the present owners of the property, and also those who purchase, mortgage or guarantee the title thereto within one year from date hereof."

1/26/99 DATE TEP/DW FIELD WORK BY



W362 \$10227 Lewin Lane Eagle, Wisconsin 53119 Terrance E.Pisarek R.L.S.

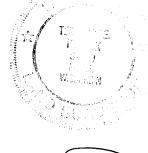

(414) 594-3484 fax (414) 594-5904

THIS IS NOT AN ORIGINAL SURVEY UNLESS THE SEAL IS RED.

TEP DRAWN BY 99015 JOB NUMBER

88 003-616

RST01-88