


PLAT OF SURVEY


LOT 107, STERLING OAKS ADDITION NO. 1, being a part of the Northwest 1/4 and Southwest 1/4 of the Northeast 1/4 and a part of the Northeast 1/4 and Southeast 1/4 of the Northwest 1/4, all in Section 20, Town 4 North, Range 18 East, Village of East Troy, Walworth County, Wisconsin.

Surveyed for: Bielinski Bros. Builders Inc/ Alex and RoseAnn Lopez

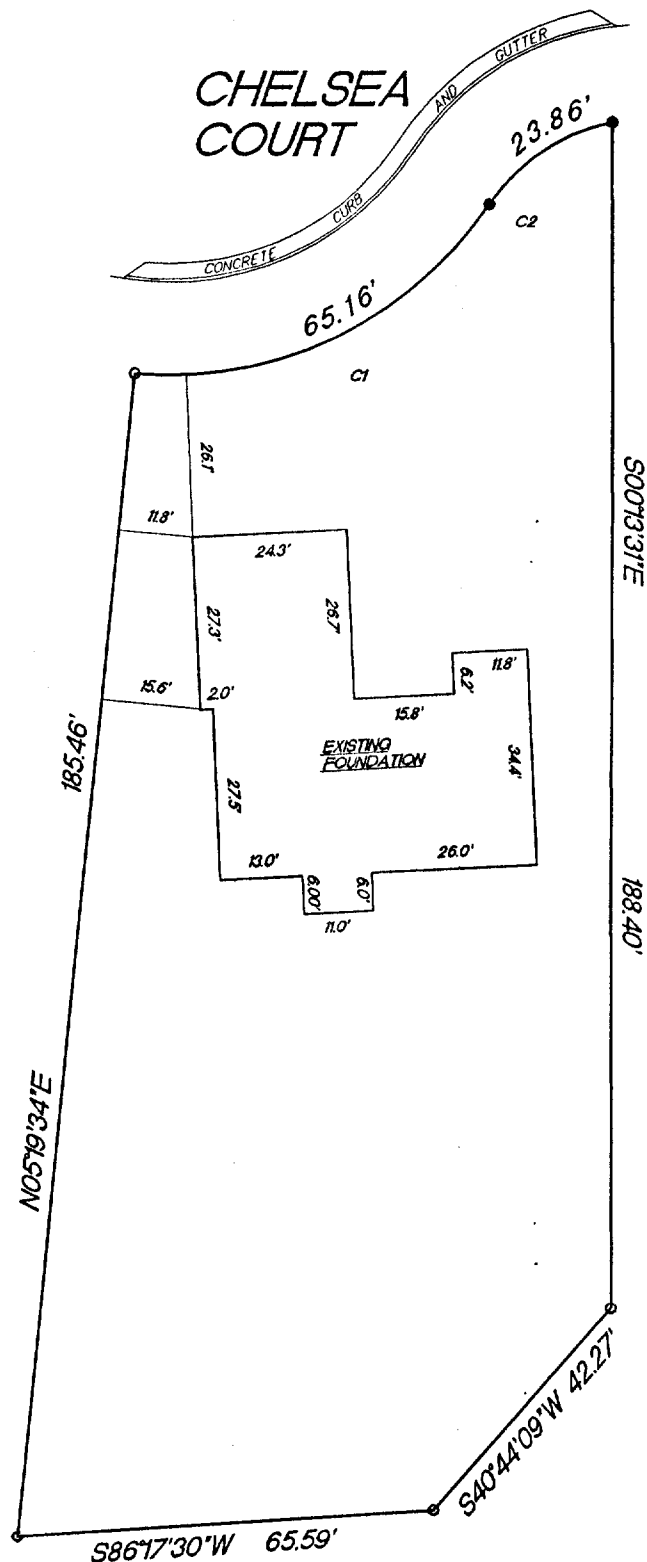

SCALE 1"=30'

- FOUND 2" IRON PIPE
- FOUND 1" IRON PIPE

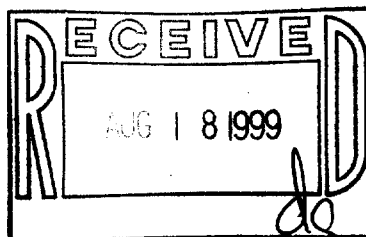

CURVE	RADIUS	LENGTH	CHORD	BEARING	DELTA
C1	60.00'	65.16'	62.01'	N64°12'52"E	62°13'45"
C2	30.00'	23.86'	23.24'	N55°53'11"E	45°34'23"

"I hereby certify that I have surveyed the above described property and that the above map is a true representation thereof and shows the size and location of the property, its exterior boundaries, the location of all visible structures and dimension of all principal buildings thereon, boundary fences, apparent easements, roadways and encroachments if any."

"This survey is made for the use of the present owners of the property, and also those who purchase, mortgage or guarantee the title thereto within one year from date hereof."



W356 S9050 Godfrey Lane
P.O. Box 357
Eagle WI. 53119

(414) 594-3484
fax (414) 594-5904

THIS IS NOT AN ORIGINAL SURVEY UNLESS THE SEAL IS RED.

REV. 8/9/99
REV. 5/3/99
DATE

TEP/DW
FIELD WORK BY

TEP
DRAWN BY

99009
JOB NUMBER

RST01-37

003-623