
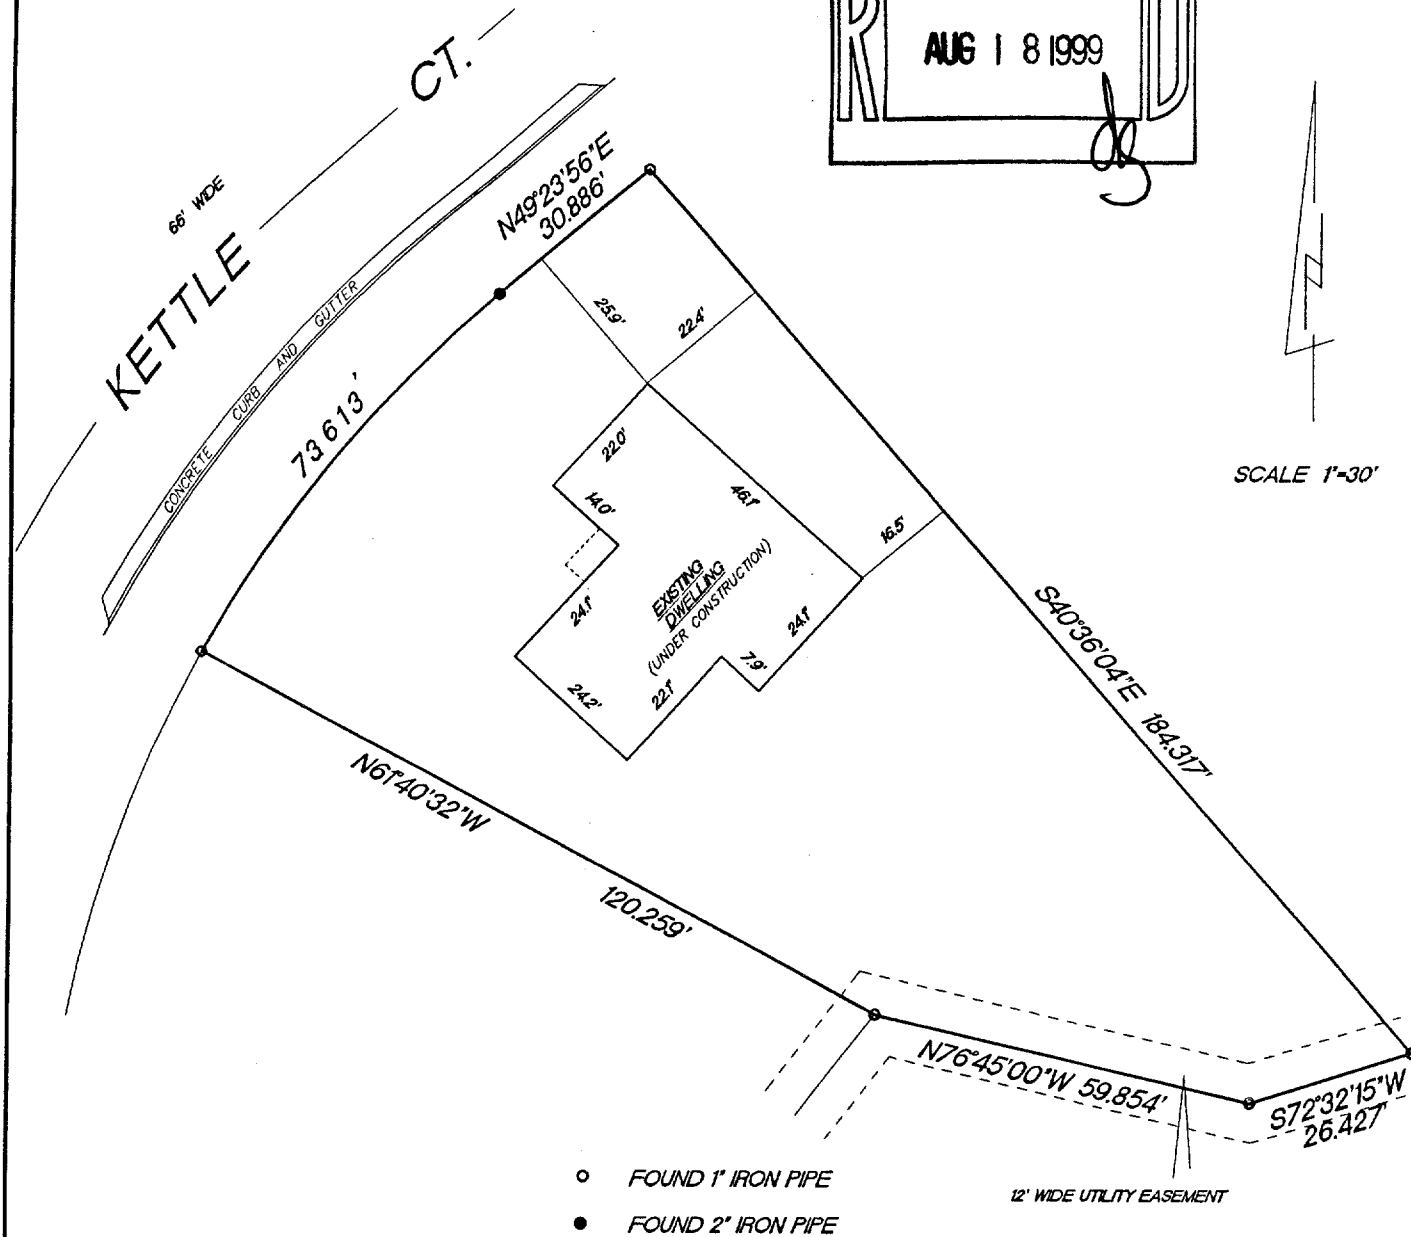


PLAT OF SURVEY

LOT 22, STERLING OAKS, being a Subdivision of part of the Southeast 1/4 of the Northwest 1/4 and part of the Northwest 1/4 and Southwest 1/4 of the Northeast 1/4 of Section 20, Township 4 North, Range 18 East, in the Village of East Troy, Walworth County, Wisconsin.

Surveyed for: Bielinski Bros. Builders

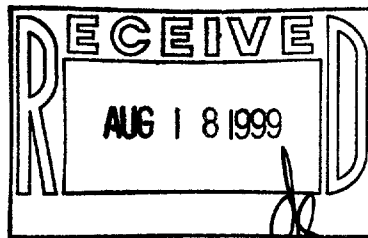

| RADIUS | LENGTH | CHORD | BEARING | DELTA |
|----------|---------|---------|-------------|-----------|
| 200.135' | 73.613' | 73.189' | N38°51'42"E | 270°4'28" |

"I hereby certify that I have surveyed the above described property and that the above map is a true representation thereof and shows the size and location of the property, its exterior boundaries, the location of all visible structures and dimension of all principal buildings thereon, boundary fences, apparent easements, roadways and encroachments if any."

"This survey is made for the use of the present owners of the property, and also those who purchase, mortgage or guarantee the title thereto within one year from date hereof."



W356 S9050 Godfrey Lane
 P.O. Box 357
 Eagle WI. 53119

(414) 594-3484
 fax (414) 594-5904

THIS IS NOT AN ORIGINAL SURVEY UNLESS THE SEAL IS RED.

REV. 6/16/99
 REV. 2/24/99
 6/30/98

DATE

TEP/PG
 FIELD WORK BY

TEP
 DRAWN BY

98141
 JOB NUMBER

RSTO-22

003-633