
## PLAT OF SURVEY

DATE: REV. 10/19/99

FOR: DESIGN BUILD, INC.

DESCRIPTION: LOT 1 OF C.S.M. #3142 BEING A REDIVISION OF LOT 2 OF C.S.M. #3141 BEING A PART OF THE SE' OF THE SW' AND THE SW' OF THE SE' OF SECTION 29. TOWN 4 NORTH, RANGE 18 EAST, VILLAGE OF EAST TROY, WALWORTH COUNTY, WISCONSIN.

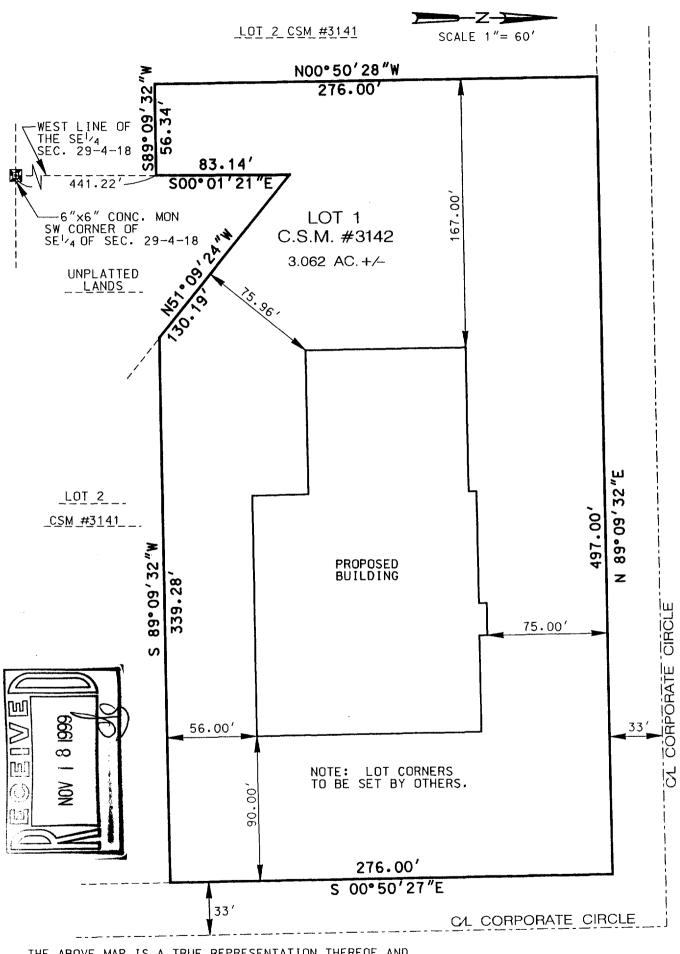

THE ABOVE MAP IS A TRUE REPRESENTATION THEREOF AND SHOWS THE SIZE AND LOCATION OF ALL THE PROPERTY, EXTERIOR BOUNDARIES, THE LOCATION OF ALL VISIBLE BOUNDARY FENCES, APPARENT EASEMENTS, ROADWAYS AND VISIBLE ENCROACHMENTS, IF ANY.

THIS SURVEY IS MADE FOR THE USE OF THE PRESENT OWNERS OF THE PROPERTY, AND ALSO THOSE WHO PURCHASE, MORTGAGE OR GUARANTEE TITLE THERETO WITHIN ONE TO YEAR FROM DATE HERETO.

BRADFORD L. SPENCER, R.L.S. 2069

THIS IS ORIGINAL PRINT ONLY IF SEAL IS IMPRINTED IN RED




## PLAT OF SURVEY

RECERT. 11/10/99

FOR: DESIGN BUILD, INC.

DESCRIPTION: LOT 1 OF C.S.M. #3142 BEING A REDIVISION OF LOT 2 OF C.S.M. #3141 BEING A PART OF THE SE'/4 OF THE SW'/4 AND THE SW'/4 OF THE SE'/4 OF SECTION 29. TOWN 4 NORTH, RANGE 18 EAST, VILLAGE OF EAST TROY, WALWORTH COUNTY, WISCONSIN.

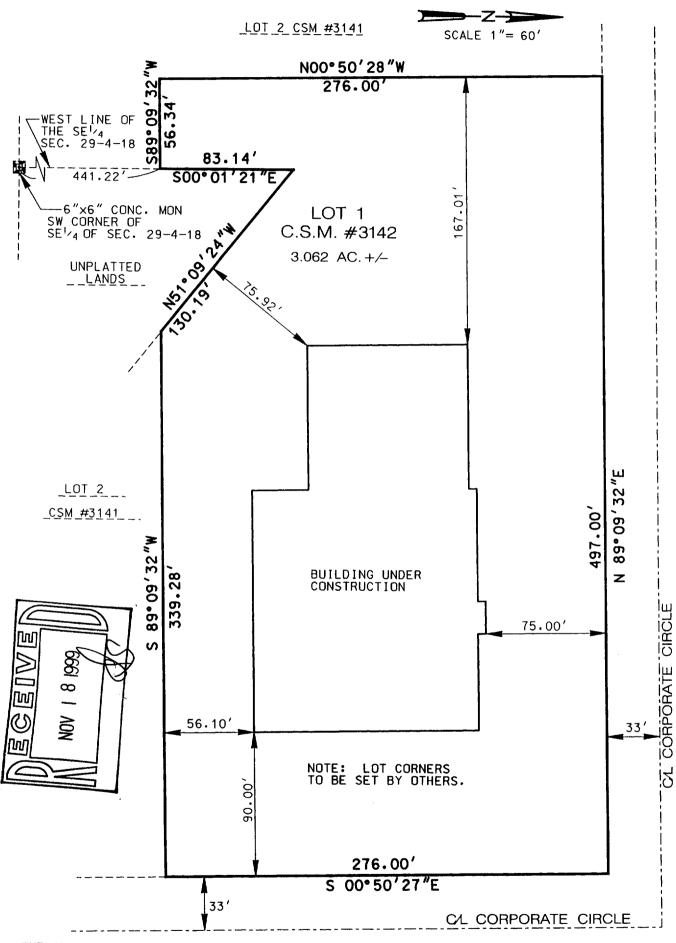

THE ABOVE MAP IS A TRUE REPRESENTATION THEREOF AND SHOWS THE SIZE AND LOCATION OF ALL THE PROPERTY, EXTERIOR BOUNDARIES, THE LOCATION OF ALL VISIBLE BOUNDARY FENCES, APPARENT EASEMENTS, ROADWAYS AND VISIBLE ENCROACHMENTS, IF ANY.

THIS SURVEY IS MADE FOR THE USE OF THE PRESENT OWNERS OF THE PROPERTY, AND ALSO THOSE WHO PURCHASE, MORTGAGE OR GUARANTEE TITLE THERETO WITHIN ONE TEAR FROM DATE HERETO.

BRADFORD L. SPENCER, R.L.S. 2069 RSV#99220 THIS IS ORIGINAL PRINT ONLY IF SEAL IS IMPRINTED IN RED



RA-3142-1