
PLAT OF SURVEY

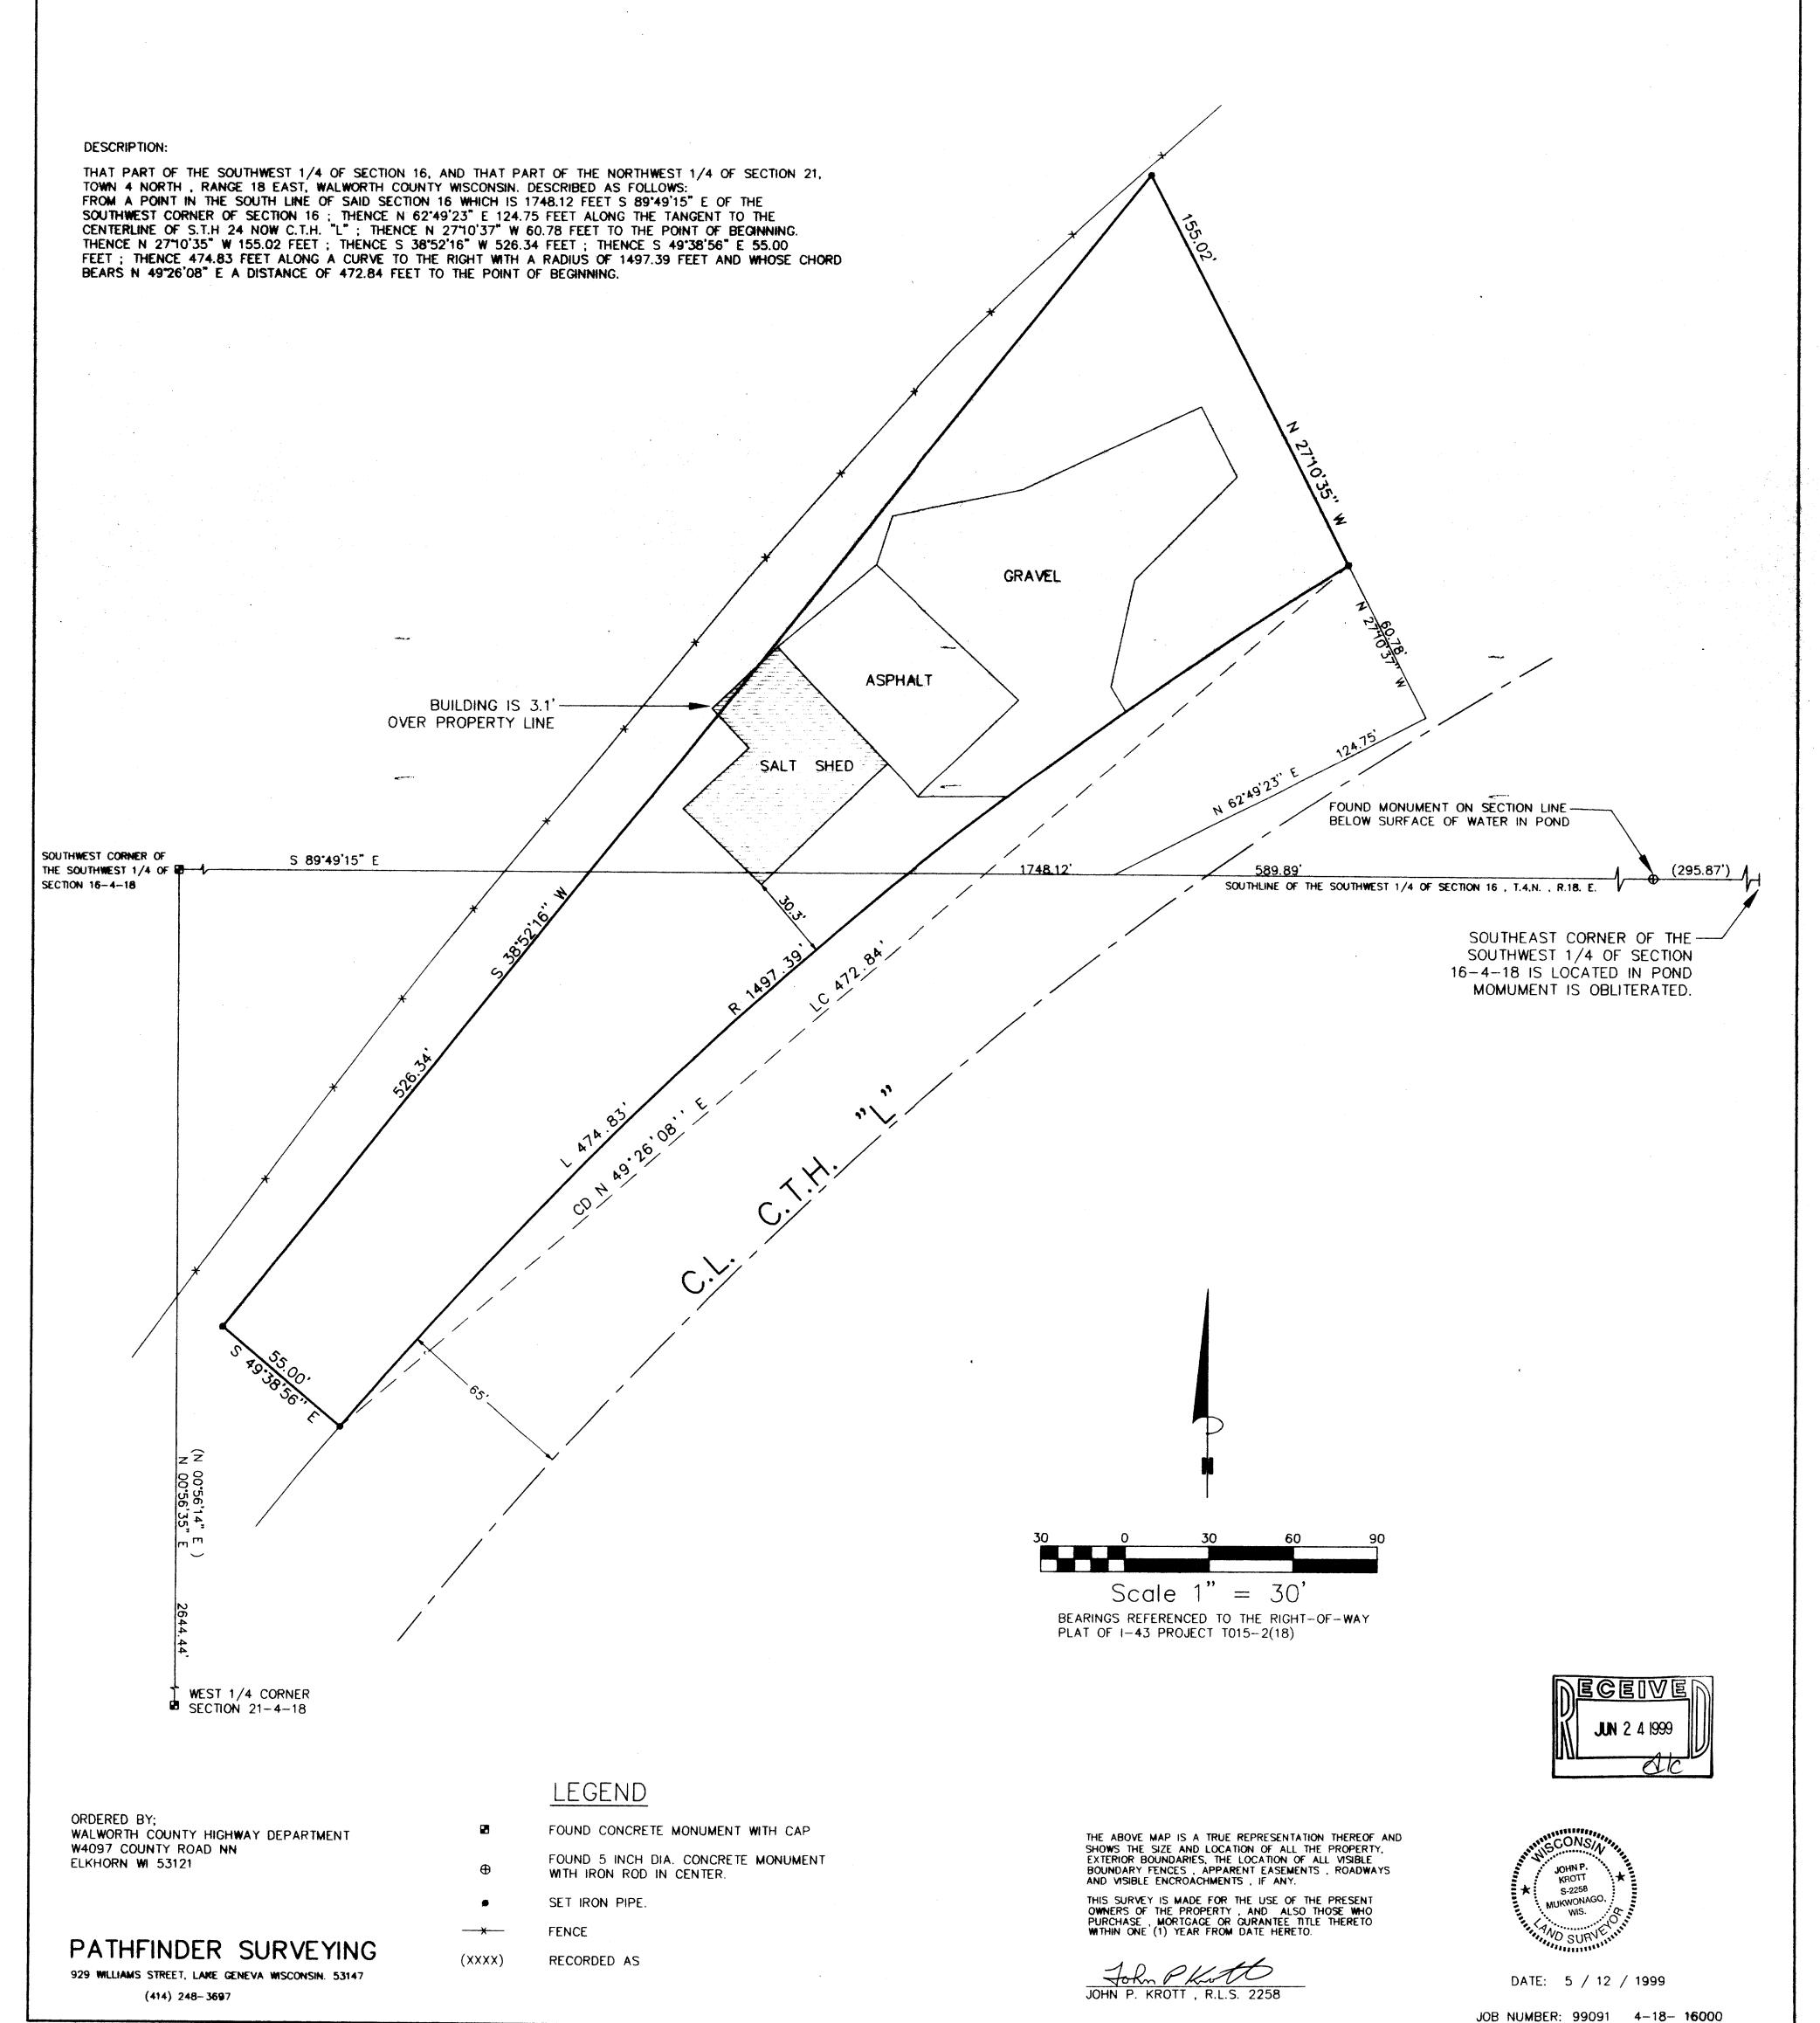

Rxur-246

003-184