
142 - 62

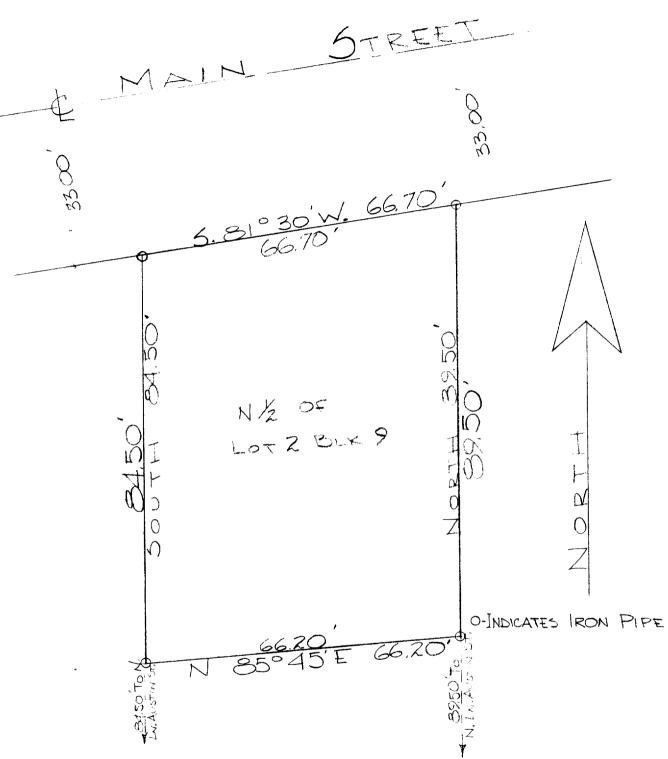

DESCRIPTION: The North ½ of Lot 2 Block 9 in the Original Plat of the Village of East Troy, Walworth County, Wisconsin.

CERTIFICATE: I, James F. Biagi, surveyor, do hereby certify that I have surveyed the property hereon described on this 24th day of April, 1962.

JAMES F. Biagi, PLS 272

BLAGI
MILWAUKEE,
WIS

3-696