

PLAT OF SURVEY

Lot 5, Block 13, of the Original Plat of the Village of East Troy, being a Subdivision of a part of Sections 19, 20, 29 and 30, Town 4 North, range 18 East, in the Village of East Troy, Walworth County, Wisconsin.

Surveyed for: Daniel and Pamela Donegan


Property address: 2110 Mill Street

66' WIDE

MILL STREET


CONCRETE CURB AND GUTTER

CONCRETE N00°23'14"W 99.00' WALK

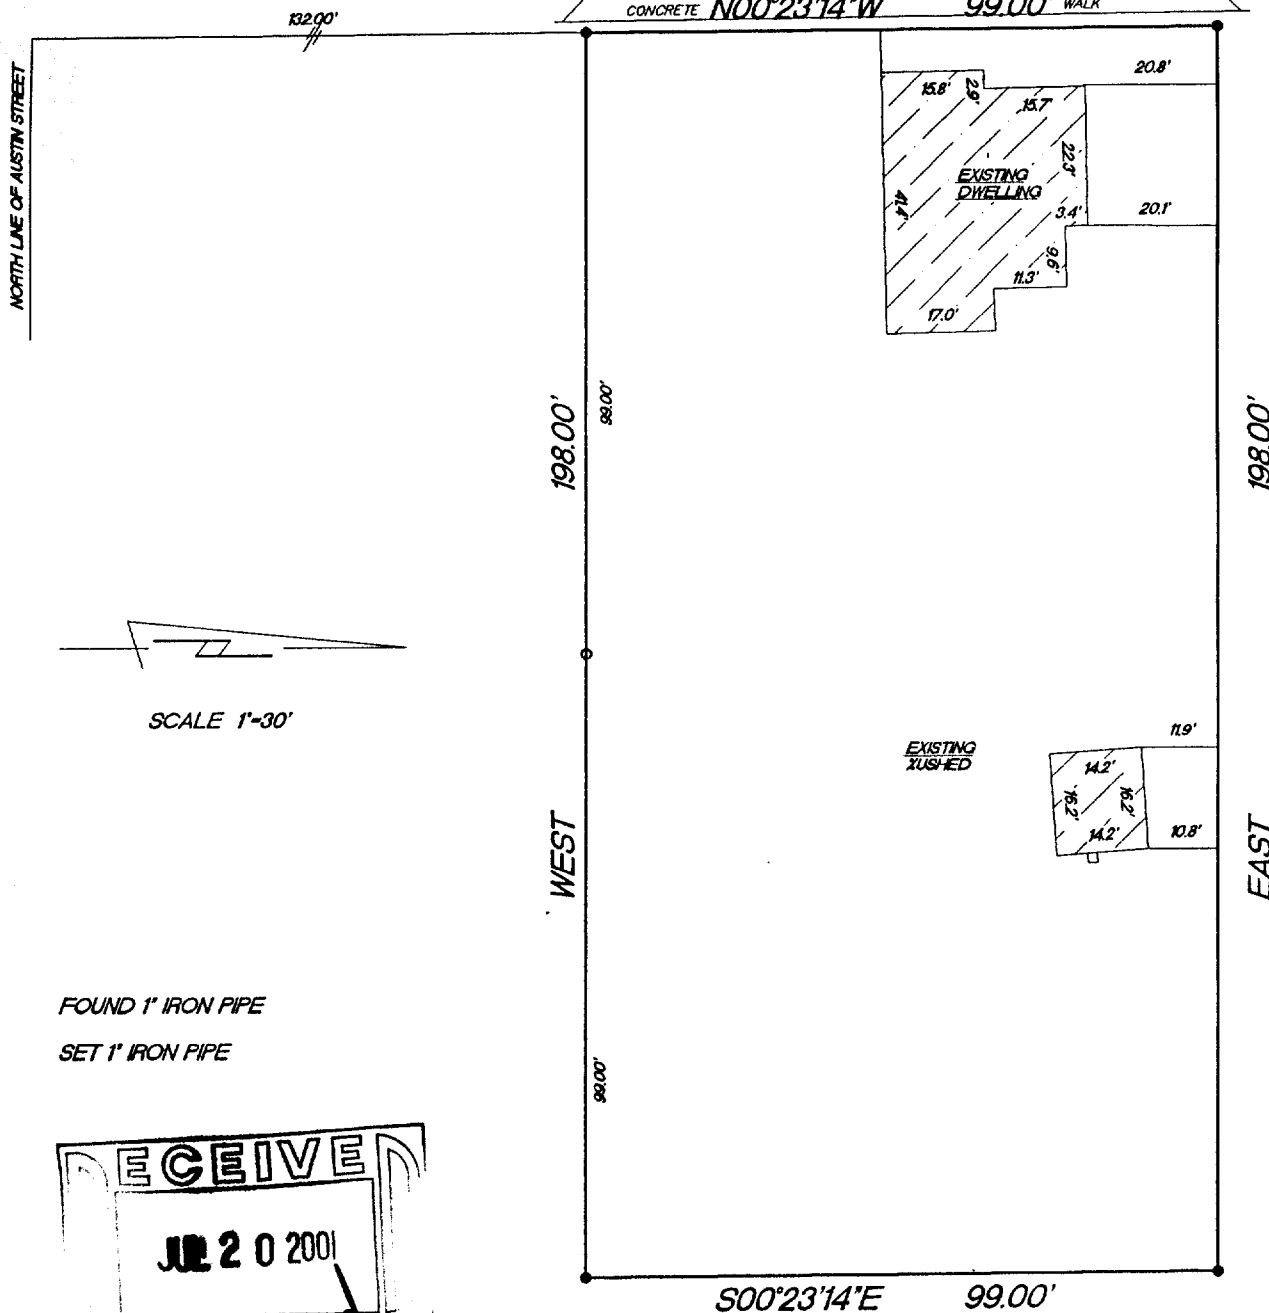

SCALE 1"=30'

- FOUND 1" IRON PIPE
- SET 1" IRON PIPE

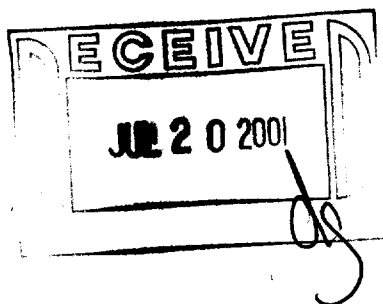

"I hereby certify that I have surveyed the above described property and that the above map is a true representation thereof and shows the size and location of the property, its exterior boundaries, the location of all visible structures and dimension of all principal buildings thereon, boundary fences, apparent easements, roadways and encroachments if any."

"This survey is made for the use of the present owners of the property, and also those who purchase, mortgage or guarantee the title thereto within one year from date hereof."

KETTLE MORaine SURVEYING
W356 S9050 Godfrey Lane
Eagle Wisconsin 53119
P.O. Box 357
(262) 594-3484

Terrance E. Pisarek R.L.S.

THIS IS NOT AN ORIGINAL SURVEY UNLESS THE SEAL IS RED.

7/3/01

DATE

TEP/DW

FIELD WORK BY

TEP

DRAWN BY

01122

JOB NUMBER

ROP-129

003-780