


48-68

3-8815

CHURCH STREET

CHURCH STREET

662'

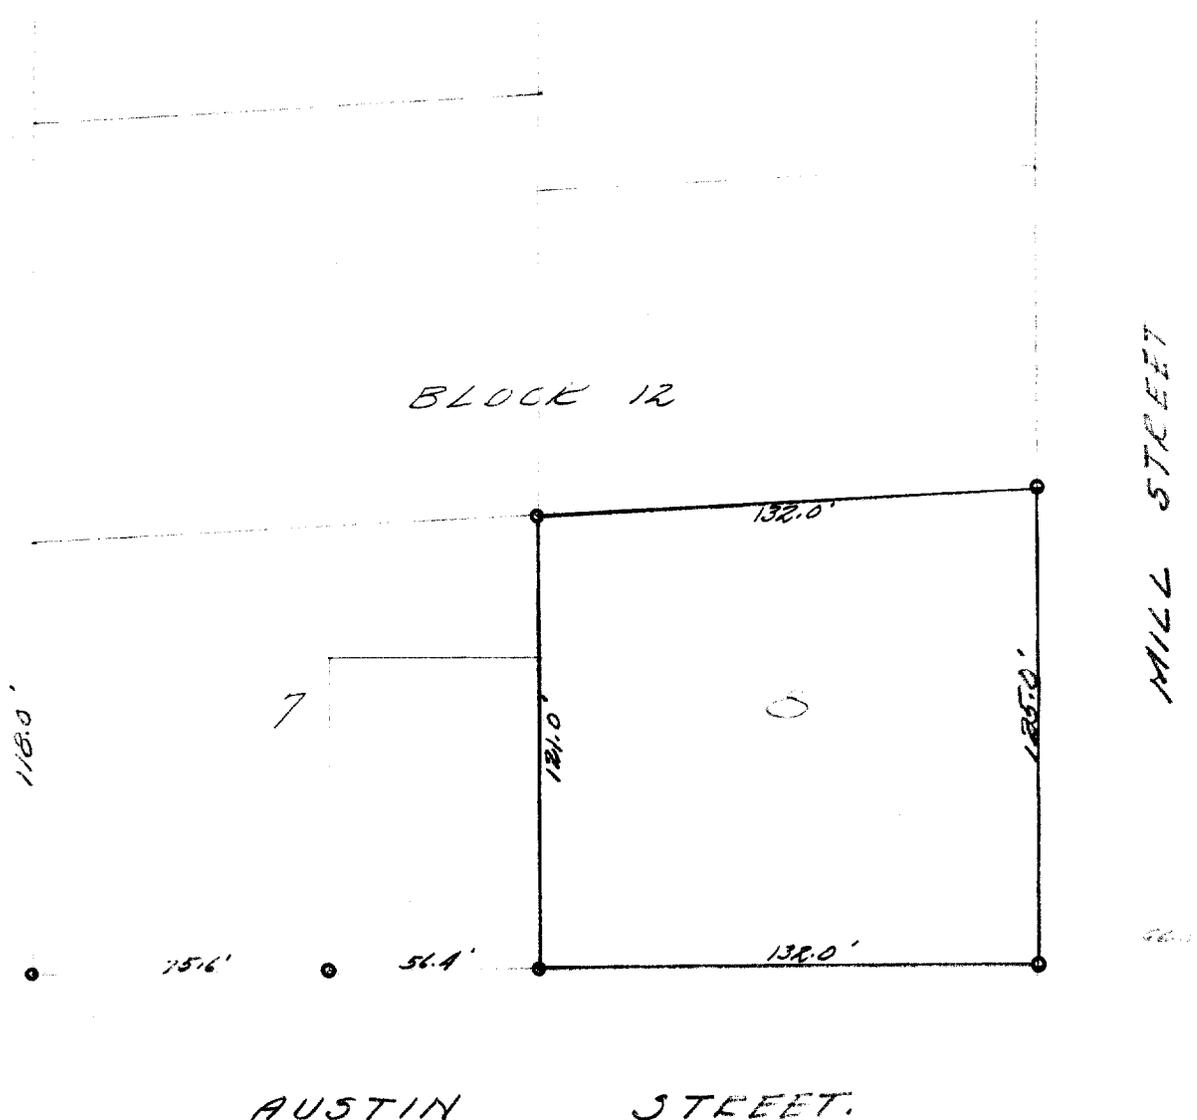

MILL STREET

662'

DESCRIPTION: Commencing at a stake that is 18 rods South of and 23 rods East of the southeast corner of Section 13, Town 4 north, Range 13 east of the 4th Principal Meridian; thence North 121.0 feet to an iron stake, thence East 120.0 feet to an iron stake, thence South 125.0 feet to an iron stake, thence West 120.0 feet to the place of beginning. Known as Lot 6, Block 12, Original Plat of the Village of East Troy, Walworth County, Wisconsin.

CERTIFICATE: I, hereby certify that I, have on this the 27th day of July 1948, surveyed, the above described property, according to the official record on file in the office of the Recorder of Deeds in and for Walworth County, Wisconsin, and find that the measurements and bearings of the boundary lines of said property as taken at the site on this day, substantially agree with those in the above description and that no encroachments exist.

SIGNED AND SEALED THIS 20th DAY OF JULY 1948.

*Joseph M. Biagi*  
Joseph M. Biagi  
Professional Engineer  
Elkhorn Wisconsin.

08-123  
OR-117

3-8815