

PLAT OF SURVEY

DESCRIPTION:



BEING LOT 10 IN BLOCK LETTERED "B" IN LENCK'S PARK ADDITION
TO THE VILLAGE OF EAST TROY, WALWORTH COUNTY, WISCONSIN.

LEGEND:


(100.00') RECORDED DISTANCE

100.00' MEASURED DISTANCE

- 1" FOUND IRON PIPE, UNLESS NOTED
- ▲ SET PK NAIL IN ASPHALT
- X FOUND CHISLED "X"
- ⊙ BASKETBALL HOOP
- ⦿ FIRE HYDRANT

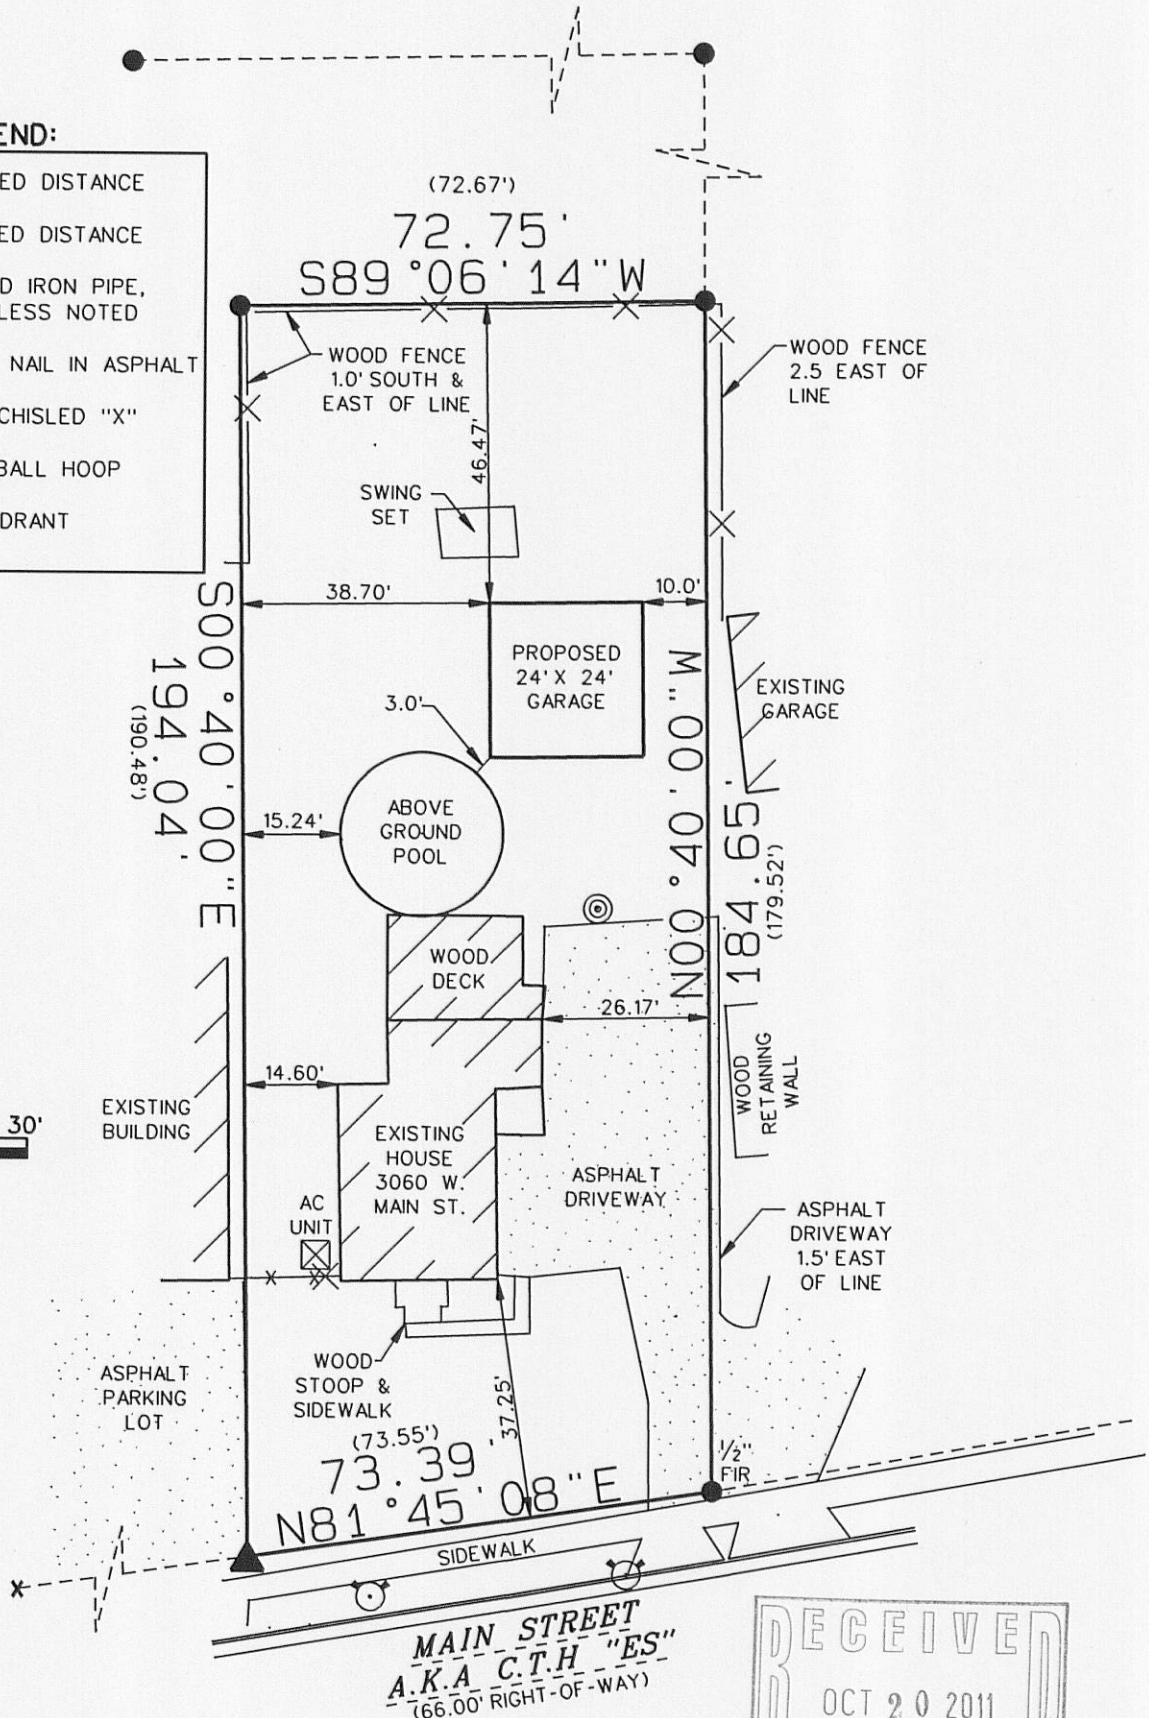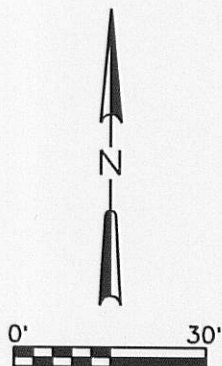

MAIN STREET
A.K.A C.T.H "ES"
166.00' RIGHT-OF-WAY

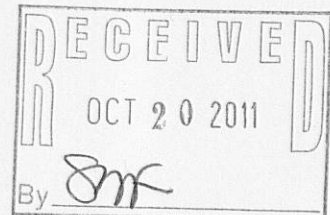


SURVEY DATE: 05/28/2010
SURVEY MADE FOR:
RICHARD ATKINSON
W2345 COUNTY ROAD D
ELKHORN, WI 53121

RSV
ENGINEERING, INC.
W232 S7530 BIG BEND DRIVE
BIG BEND, WI 53103
(262) 662-4292

THIS SURVEY IS MADE FOR THE USE OF THE
PRESENT OWNERS OF THE PROPERTY, AND
ALSO THOSE WHO PURCHASE, MORTGAGE OR
GUARANTEE TITLE TO WITHIN ONE (1) YEAR
FROM DATE HERETO.

I, MICHAEL A. GREESON R.L.S. #2770, HEREBY CERTIFY
THIS SURVEY WAS MADE IN ACCORDANCE WITH
THE MINIMUM STANDARDS FOR PROPERTY SURVEYS
(CHAPTER A-E 7) FOR THE STATE OF WISCONSIN AND
HAS BEEN PREPARED UNDER MY DIRECTION AND
CONTROL AND IS CORRECT TO THE BEST OF MY
KNOWLEDGE AND BELIEF.

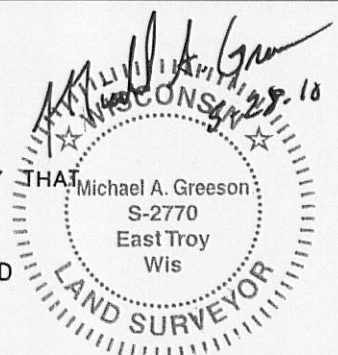

PLOT DATE: 5/28/2010

RSV JOB#: 10-048 ATKINSON

RLP-31

003-986