


PLAT OF SURVEY PART OF BLOCK 9 ORIGINAL PLAT OF THE CITY OF ELKHORN WALWORTH COUNTY, WISCONSIN

LEGAL DESCRIPTION
PART OF LOT 2, BLOCK 9 OF THE ORIGINAL PLAT OF THE VILLAGE (NOW CITY OF)
ELKHORN, WISCONSIN DESCRIBED AS FOLLOWS: THE EAST 1/2 AND THE SOUTHWEST 1/4 OF
SAID LOT 2.

LEGAL DESCRIPTION
LOT LINE ADJUSTMENT PARCEL

A PARCEL OF LAND BEING PART OF LOT 3 OF BLOCK 9 OF THE
ORIGINAL PLAT OF THE CITY OF ELKHORN, WALWORTH COUNTY,
WISCONSIN, TO BECOME APPURTENANT TO LOT 2 OF SAID BLOCK 9,
AND DESCRIBED AS FOLLOWS:
COMMENCING AT THE NORTHWEST CORNER OF SAID LOT 3; THENCE N
N89DEG 56MIN 53SEC E, 74.14 FEET ALONG THE SOUTH LINE OF
LOT 2 OF SAID BLOCK 9 TO THE POINT OF BEGINNING; THENCE
CONTINUE N 89DEG 56MIN 53SEC E, 54.73 FEET; THENCE S 03DEG
07MIN 25SEC E, 3.83 FEET; THENCE S 88DEG 07MIN 57SEC W,
54.75 FEET; THENCE N 02DEG 13MIN 15SEC W, 5.57 FEET TO THE
POINT OF BEGINNING. CONTAINING 257 SQUARE FEET OF LAND
MORE OR LESS.

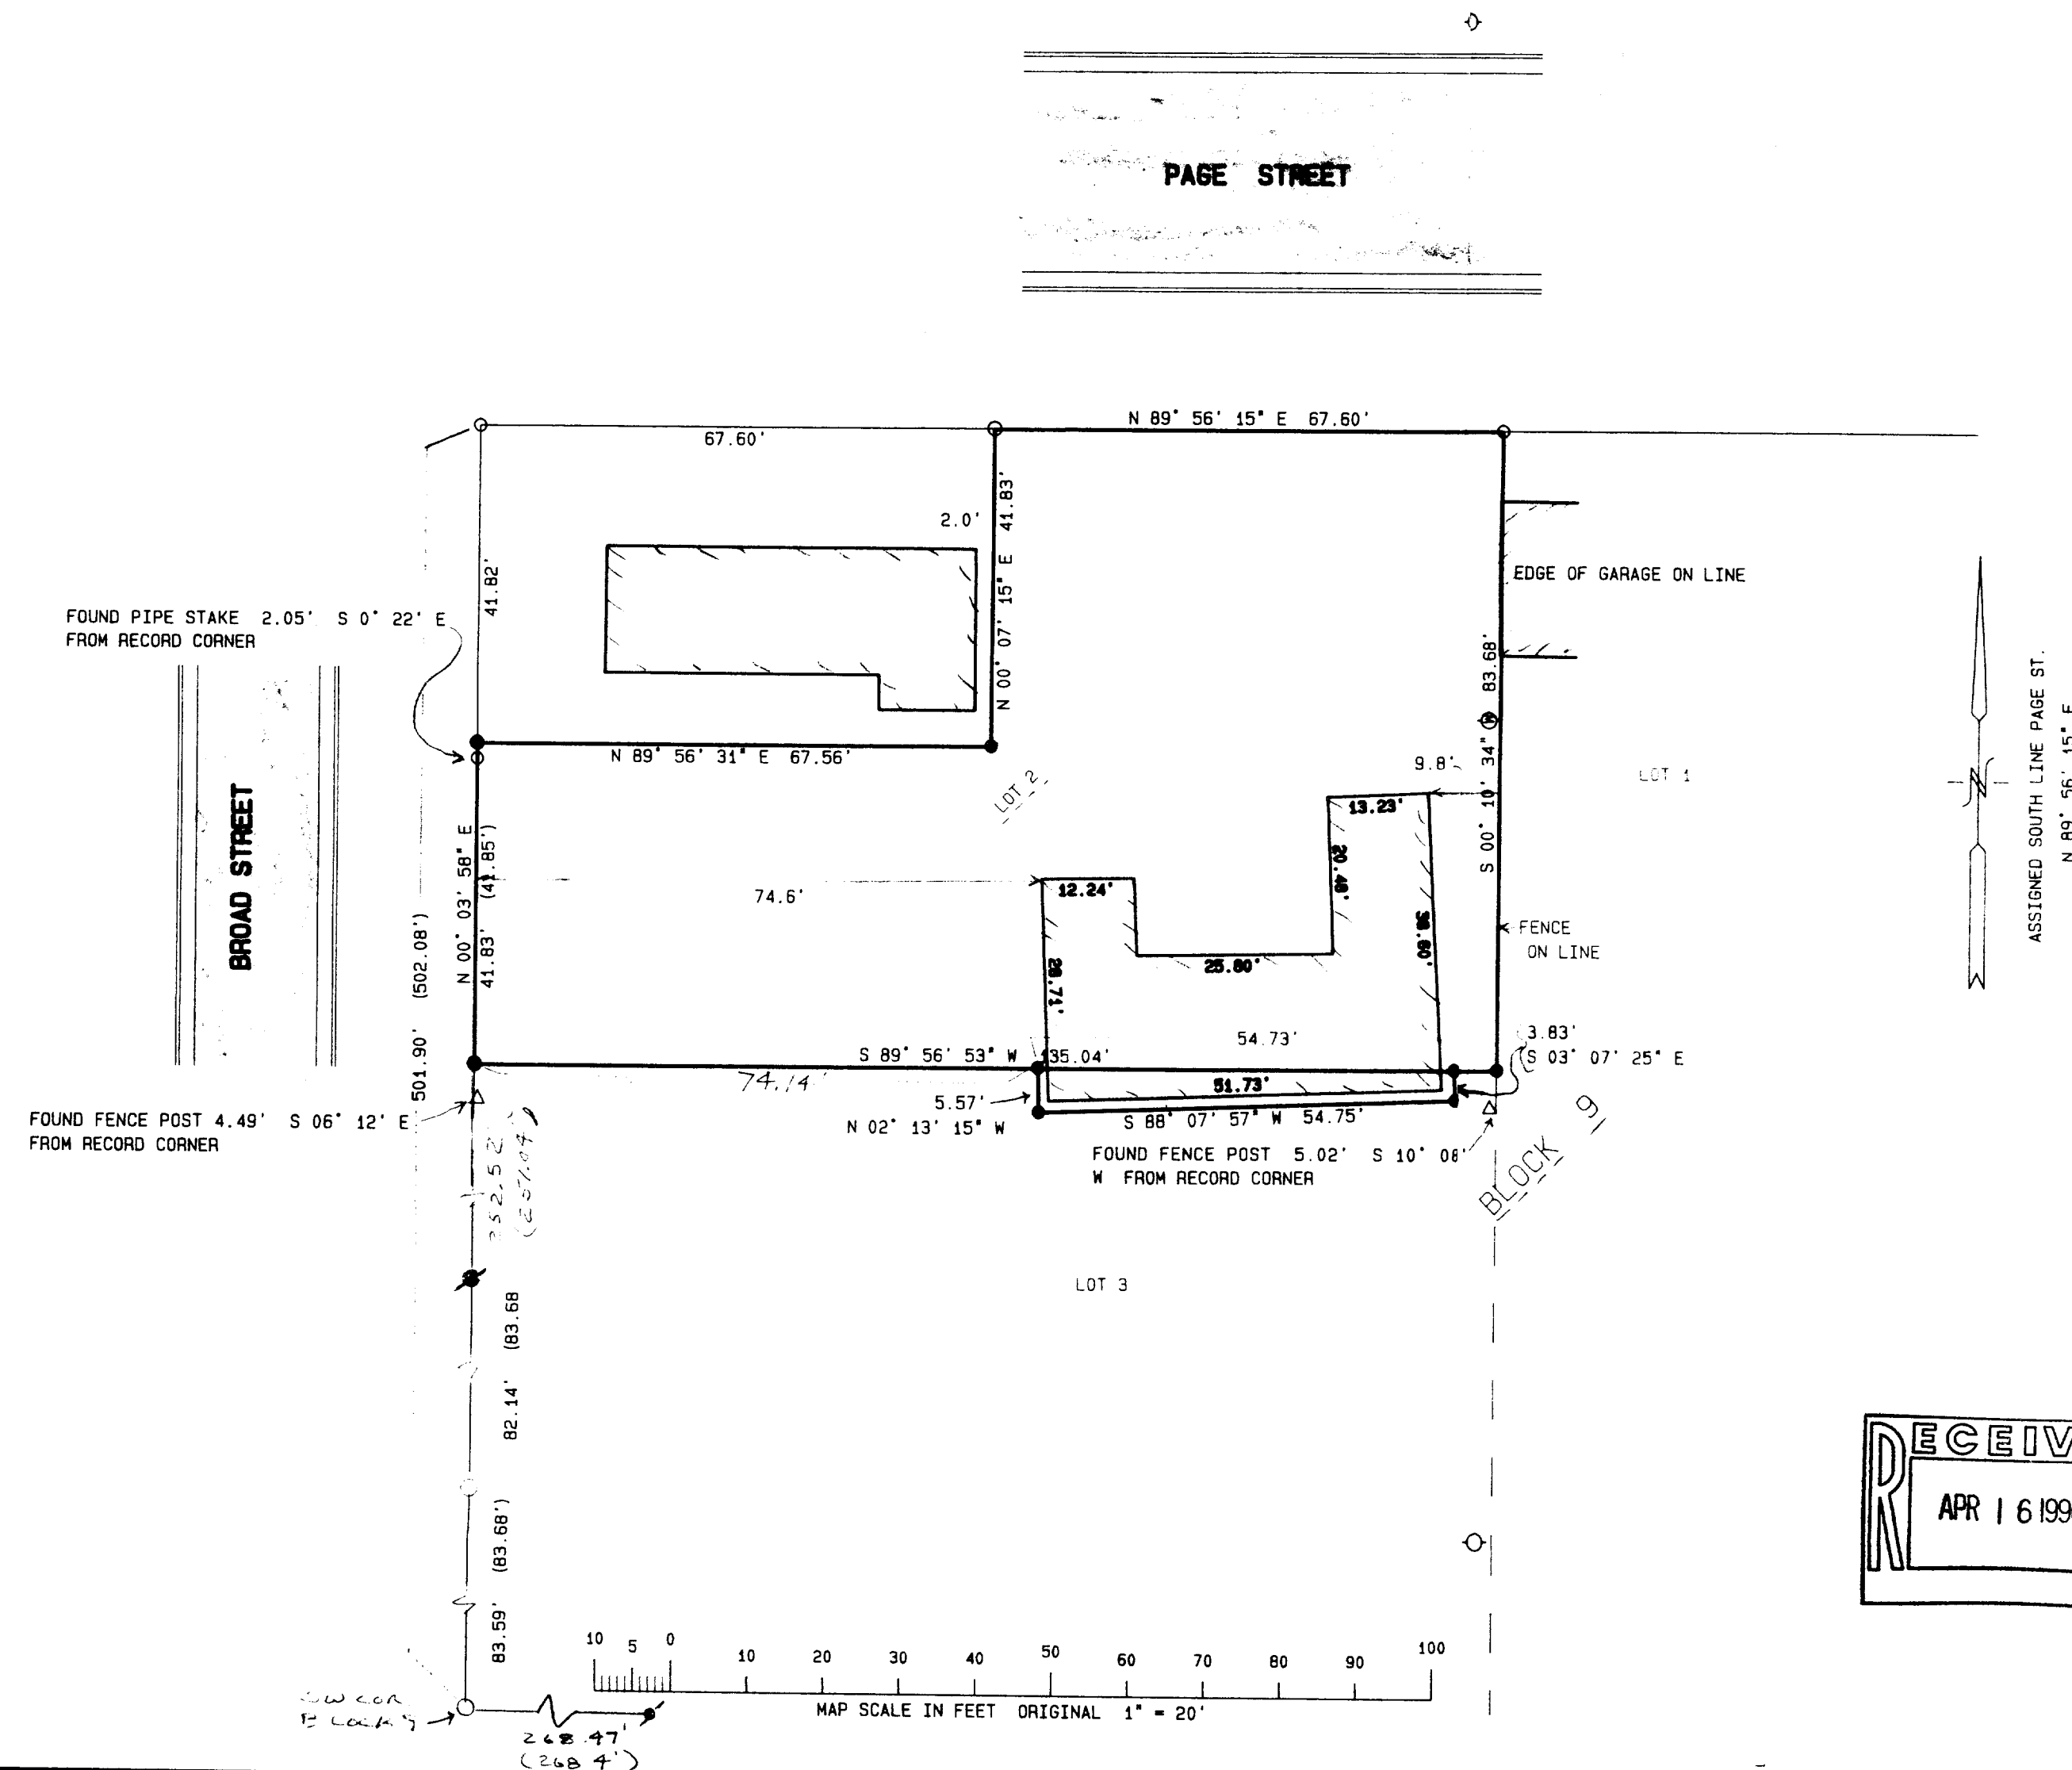

WORK ORDERED BY: ERA CORNER REALTY
FOR SHAWN KAWCZYNSKI
5362 STATE RD 11
ELKHORN, WI. 53121

FARRIS, HANSEN & ASSOCIATES, INC.
Engineering, Architecture, Surveying
7 Ridgeway Court, P.O. Box 437
ELKHORN, WISCONSIN 53121
Office: (414) 723-2098
Fax: (414) 723-5886

REVISIONS

PROJECT NO.
4469
DATE
03/12/96
SHEET NO.
1 OF 1

