


61-64

CHURCH STREET

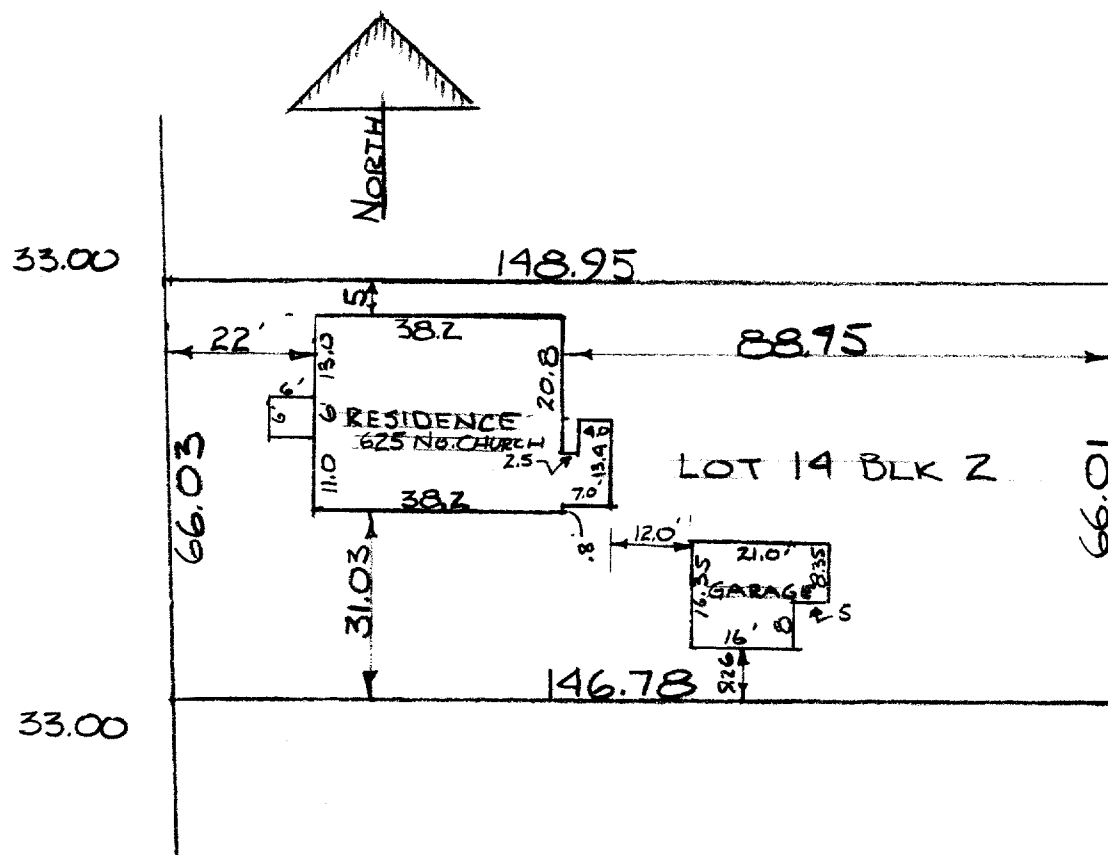


DESCRIPTION: Lot 14 of Block 2 of Holton Heights Addition to the City of Elkhorn, Walworth County, Wisconsin.

CERTIFICATE: I, James F. Biagi, Surveyor, do hereby certify that I have surveyed the property hereon described and that the location of the improvements are as shown on the drawing.

October 24, 1961

James F. Biagi
James F. Biagi, P.S. 272

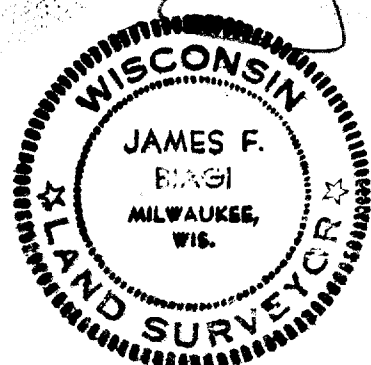

YHT-22

4-101B