


TELEPHONE
542-5616

RONALD H. ZIMMERMAN
REGISTERED LAND SURVEYOR

PLAT OF SURVEY
FOR
~~WAUKESHA SAVINGS & LOAN~~

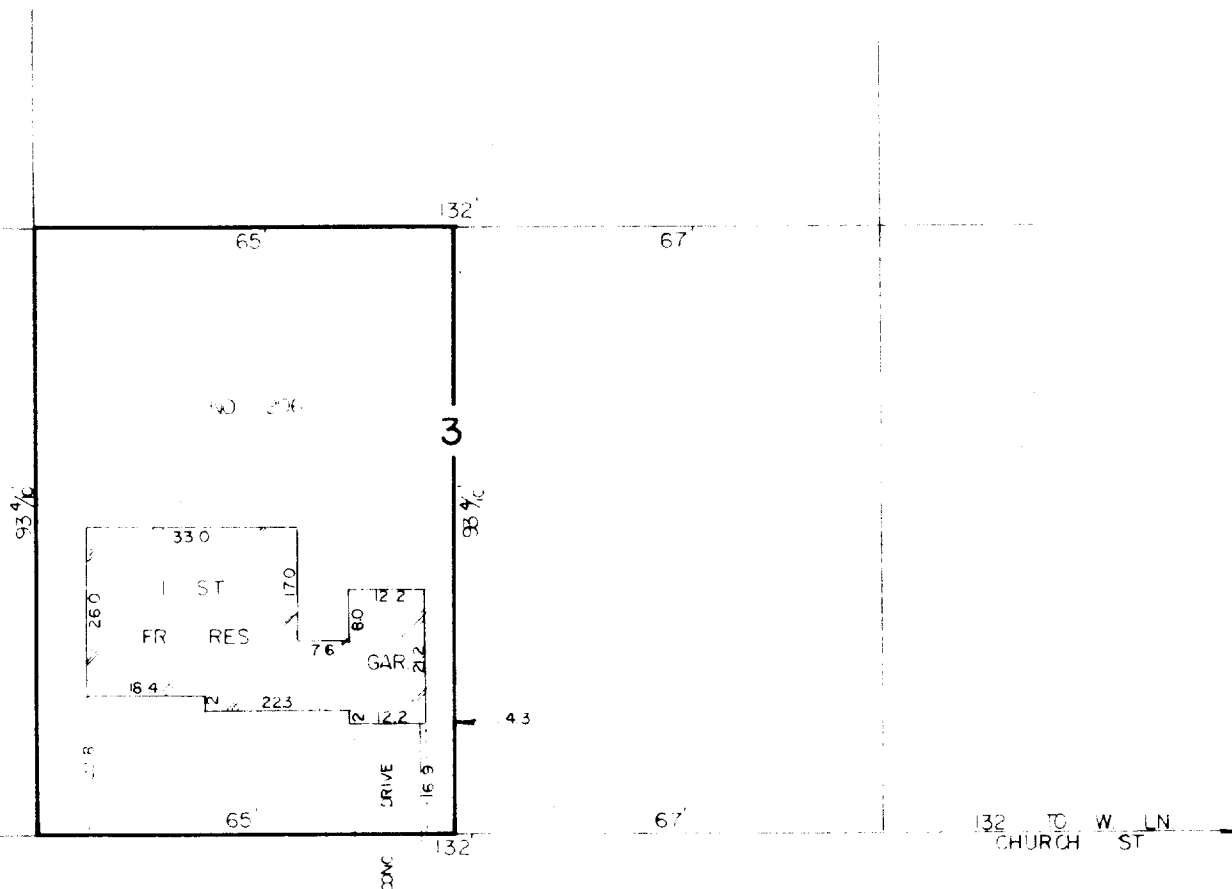

99

N.

PAGE

STREET

SCALE 1" = 30'

CERTIFICATION

STATE OF WISCONSIN)
COUNTY OF WAUKESHA) SS

I, RONALD H. ZIMMERMAN, REGISTERED LAND SURVEYOR, DO HEREBY CERTIFY THAT I HAVE MADE A SURVEY OF W. 65' LOT 3, BLK 6, ORIGINAL PLAT OF VILLAGE OF ELKHORN AND THE EXISTING BUILDING AND IMPROVEMENTS LOCATED THEREON AND THAT THE PLAT HEREWITH DRAWN IS A CORRECT REPRESENTATION OF SAID SURVEY.

DATE NOV 30, 1973

RONALD H ZIMMERMAN

S - 868

4-102