

W 238 S 3712 BIG BEND ROAD
WAUKESHA, WIS 53186

TELEPHONE
542-5616

RONALD H. ZIMMERMAN
REGISTERED LAND SURVEYOR

PLAT OF SURVEY

FOR

WAUKESHA SAVINGS & LOAN

WINSOR

STREET

50'


202.12' TO E LINE
ELM STREET

4' CONC WALK

N 89° 45' E

66'

2.5' DRV
ENC.

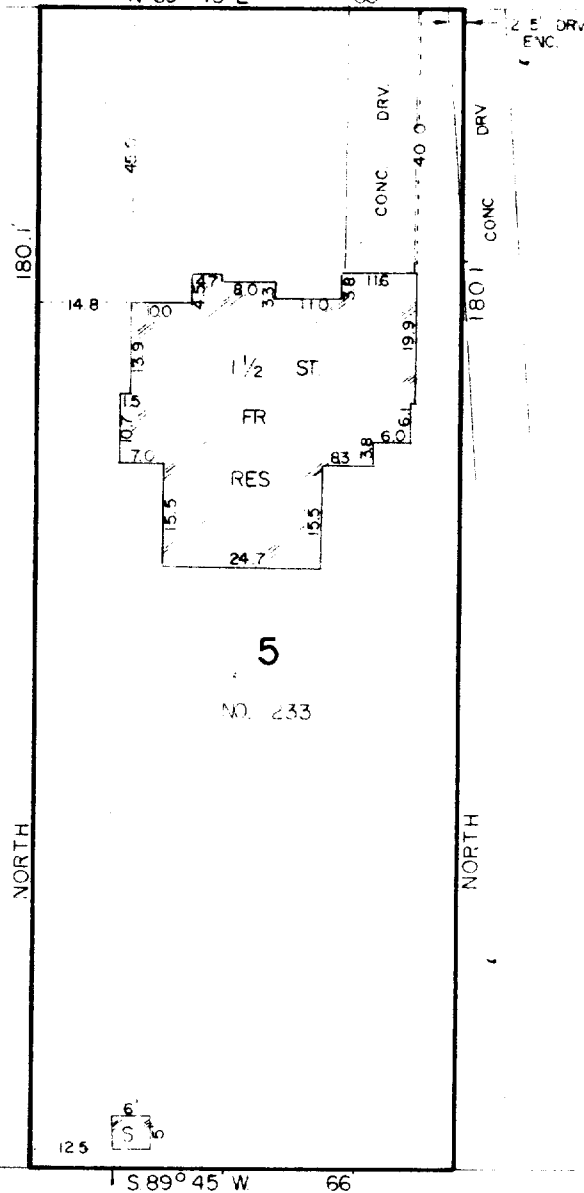

SCALE 1" = 30'

6

5

4

CERTIFICATION

STATE OF WISCONSIN)
COUNTY OF WAUKESHA) SS

I, RONALD H. ZIMMERMAN, REGISTERED LAND SURVEYOR, DO HEREBY CERTIFY THAT I HAVE MADE A SURVEY
OF LOT 5, BLK 2, RIDGWAY - MARTIN ADD, CITY OF ELKHORN, WALWORTH CO.
AND THE EXISTING BUILDING AND IMPROVEMENTS LOCATED THEREON AND THAT THE PLAT HEREWITH DRAWN
IS A CORRECT REPRESENTATION OF SAID SURVEY.

DATE NOV. 30, 19 73

YRM-16

RONALD H. ZIMMERMAN

S - 868

4-105