


#207-70

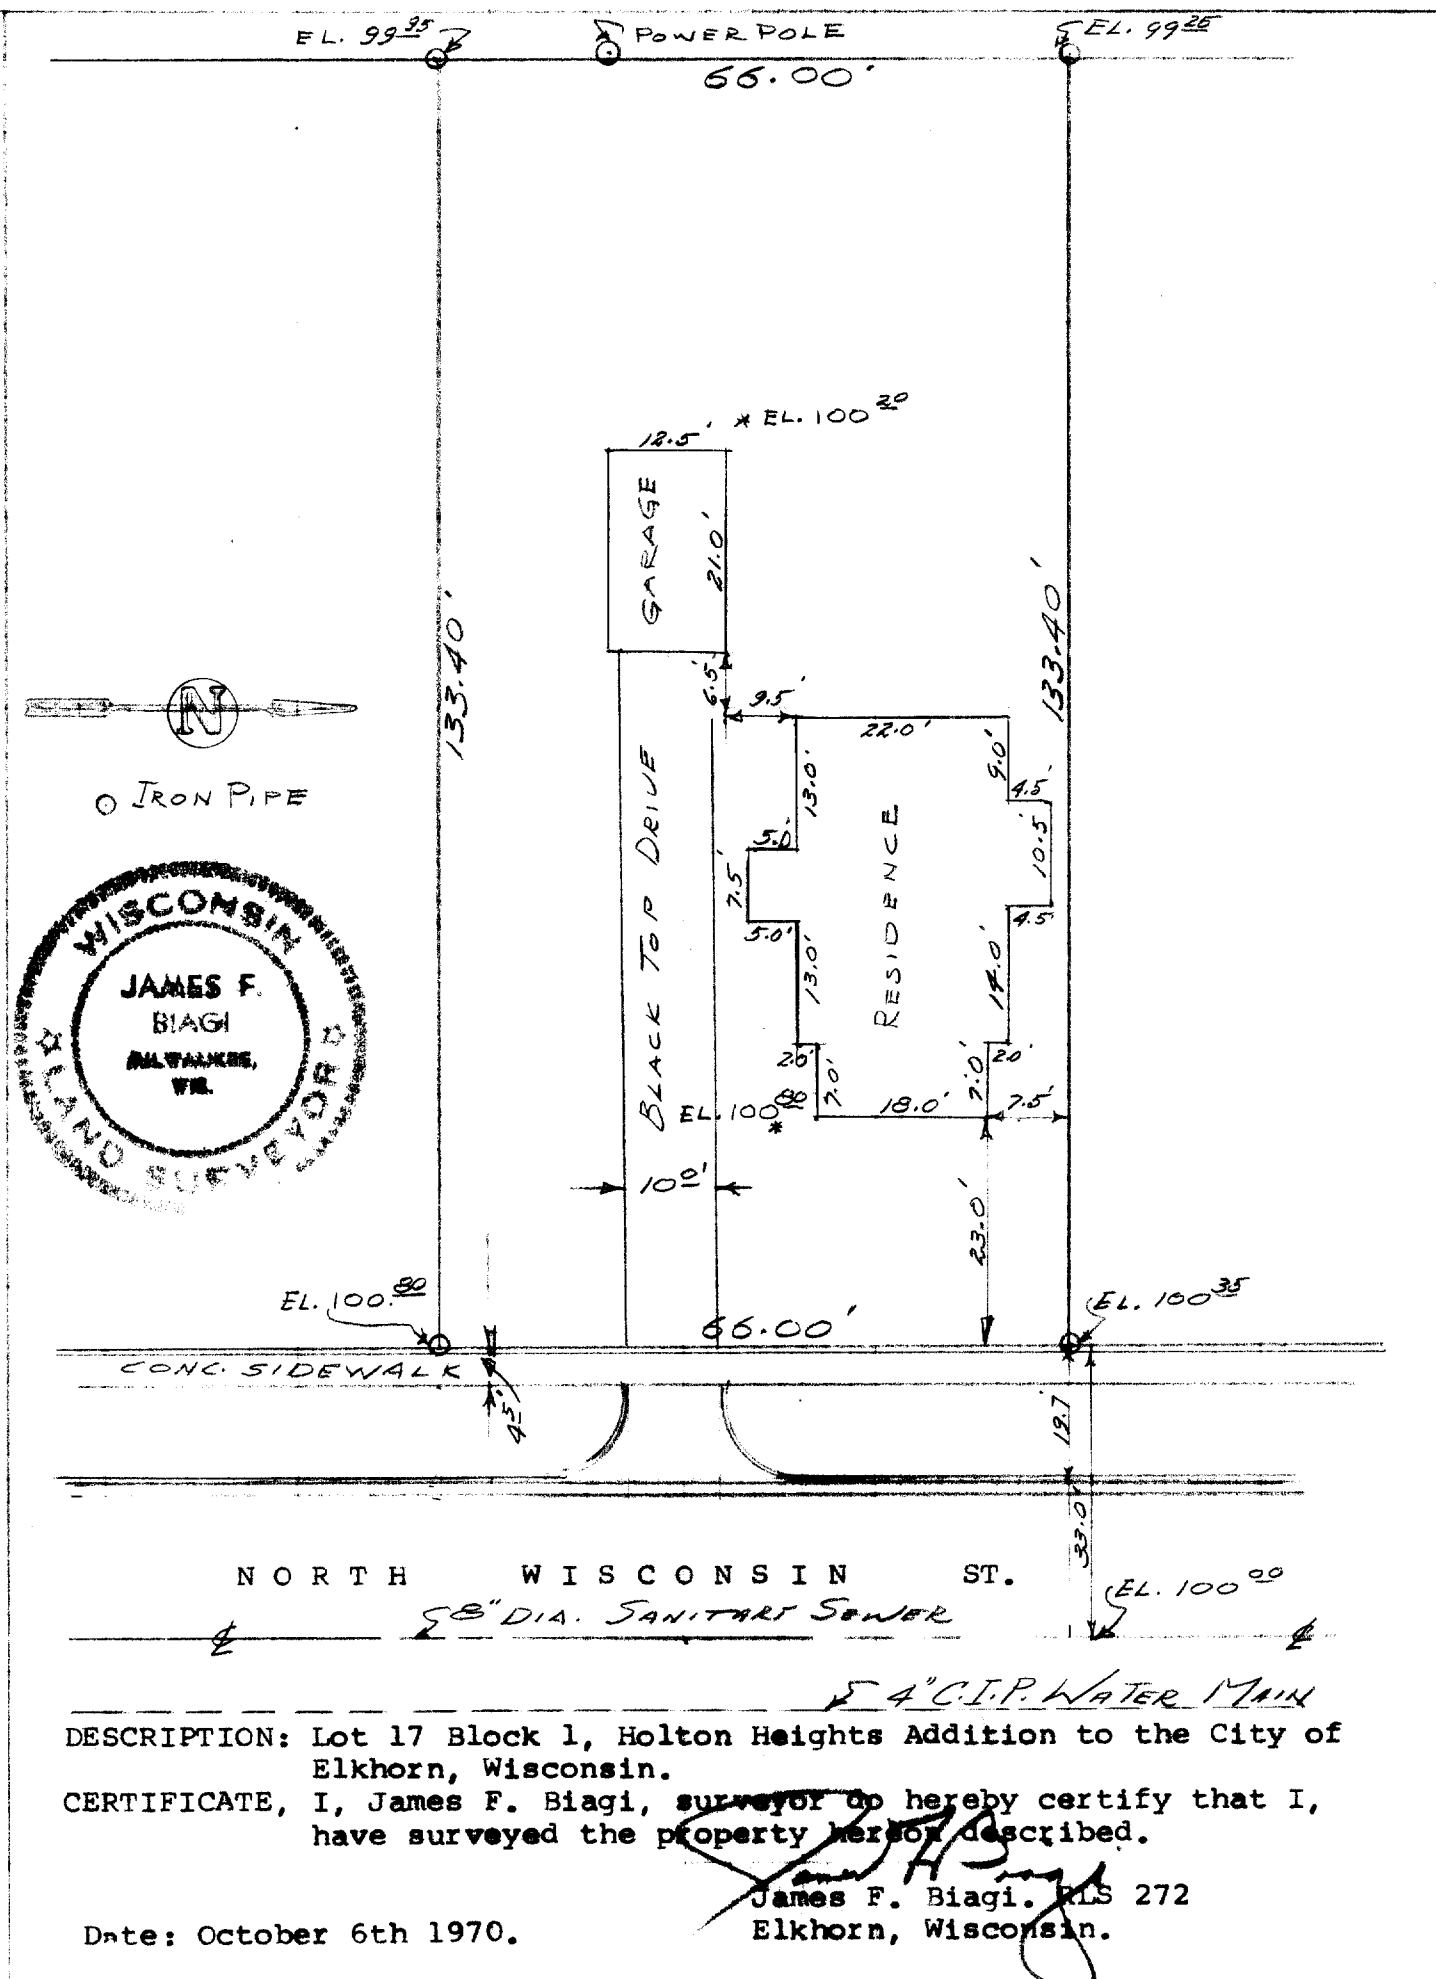

4-105B